T.15S. R.10E. W.M.

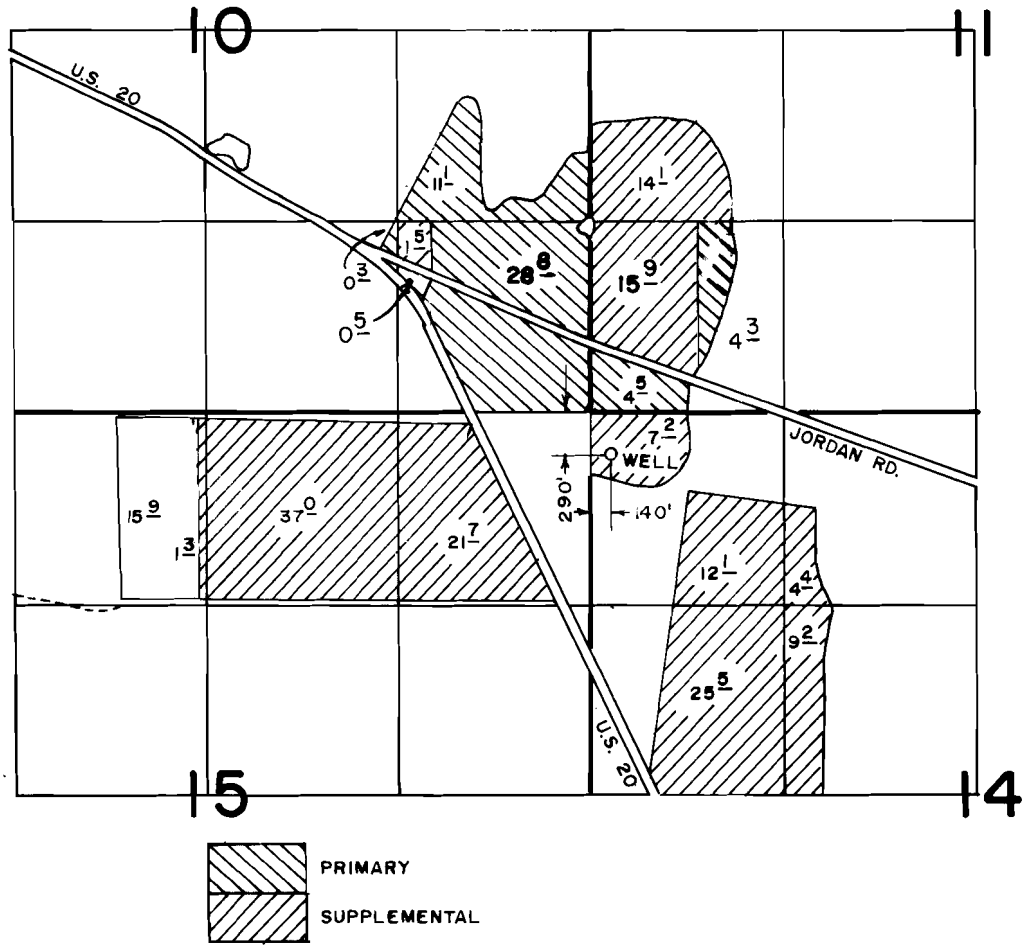

FINAL PROOF SURVEY

UNDER

Application No. G-5295 Permit No. G-4841

IN NAME OF

L.F. BROGAN

Surveyed APR. 24 1980, by L.H. NUNN

REVISED 5/29/88 JN

SCID 15-10-14