


T.1N., R.16E. W. M.

SCALE: 1"=1320'

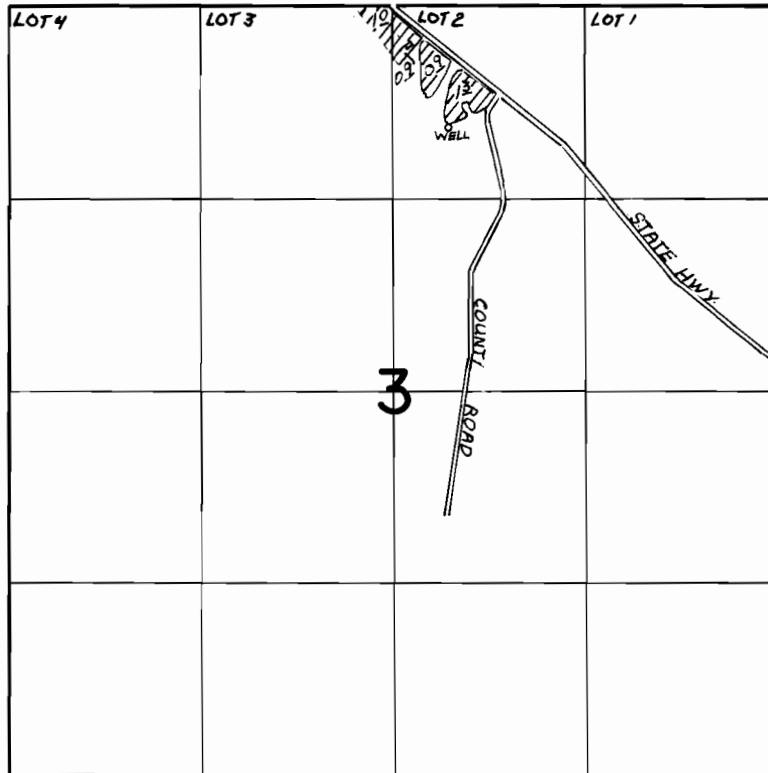

WELL LOCATED 840' S. AND 400' E. FROM NE 1/4 COR. SEC. 3

FINAL PROOF SURVEY UNDER

Application No. G-5423 Permit No. G-5352
IN NAME OF

LE KASEBERG

Surveyed MAY 7 1985, by V.L. CHURCH