


T. 16S. R. 5W. W.M.

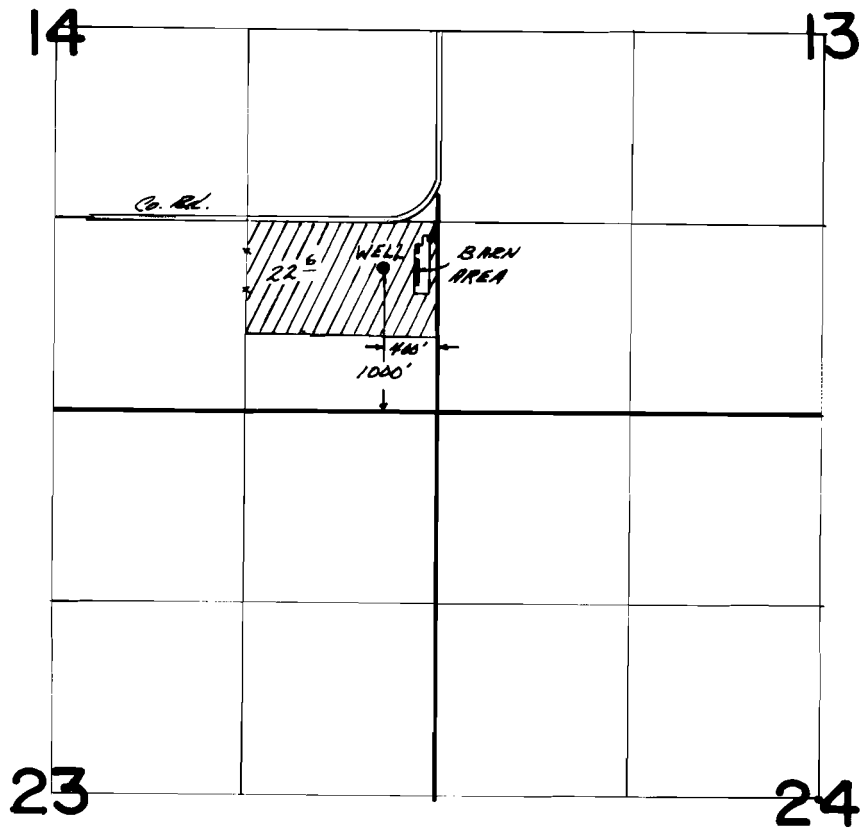

FINAL PROOF SURVEY
UNDER

Application No. G-5577 Permit No. G-5439.....
IN NAME OF

.....CLARENCE BROLIN.....

Surveyed Oct...11... 1979, by C.R. RODRIGUEZ