


T. 36S., R.1W., W. M.

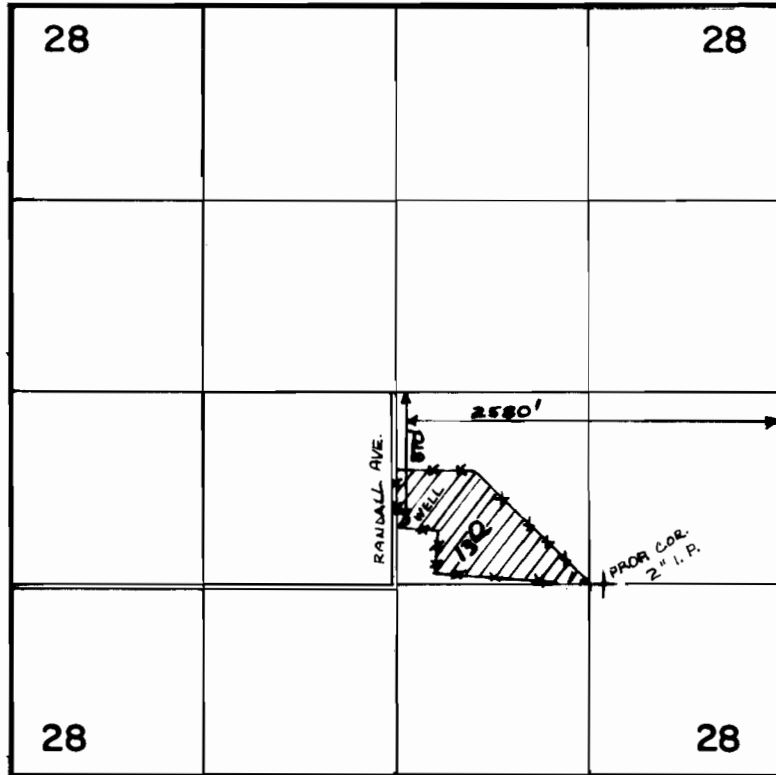

SCALE : 1" = 1320'

**FINAL PROOF SURVEY**  
UNDER

G-6048                      G-5743  
Application No. .... Permit No. ....  
IN NAME OF

**JAMES G. TOWE**  
.....

Surveyed **JUNE 15** 19**84**, by **B.S. JAMES**  
.....