


T. 36 S., R. 6 W., W.M.

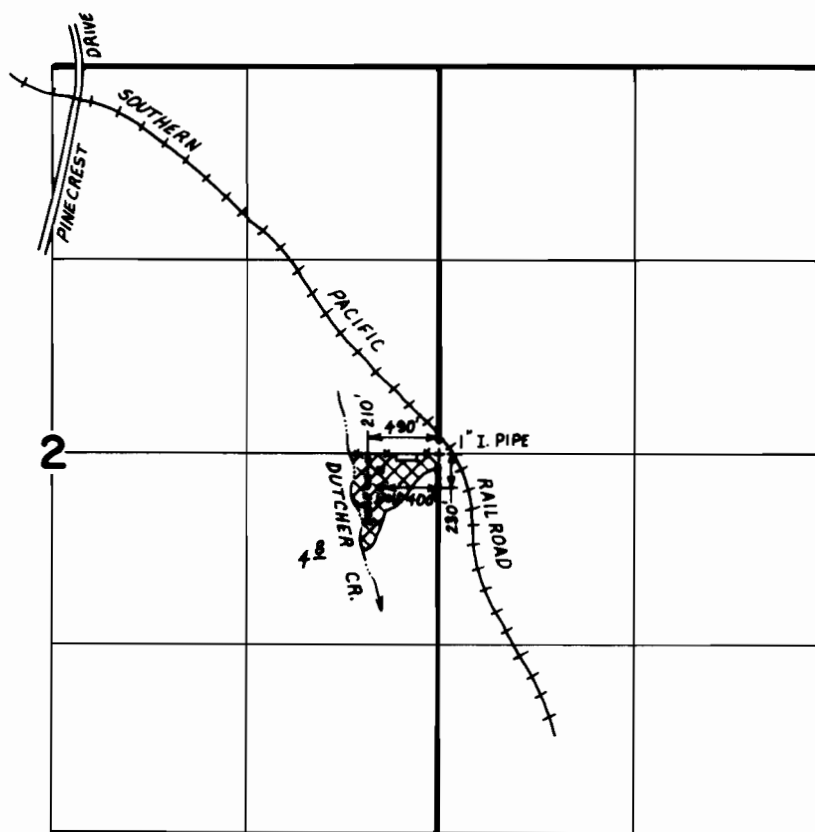

Scale: 4" = 1 mile

- ☒ PRIMARY IRRIGATION from SUMP
- ☒ SUPPLEMENTAL IRRIGATION from WELL

FINAL PROOF SURVEY
UNDER

Application No. G-6067 Permit No. G-5757
IN NAME OF

FRED A. & SHIRLEY L. SARGENT

Surveyed JAN. 17 1984, by B. S. JAMES