


T. 12S., R. 2W., W.M.



FINAL PROOF SURVEY

UNDER

Application No. G-6829 Permit No. G-6324
IN NAME OF

ARZIE DRAIN

Surveyed APR. 29, 1982, by L. M. TOLL.....