


T.2S., R.2W., W.M.

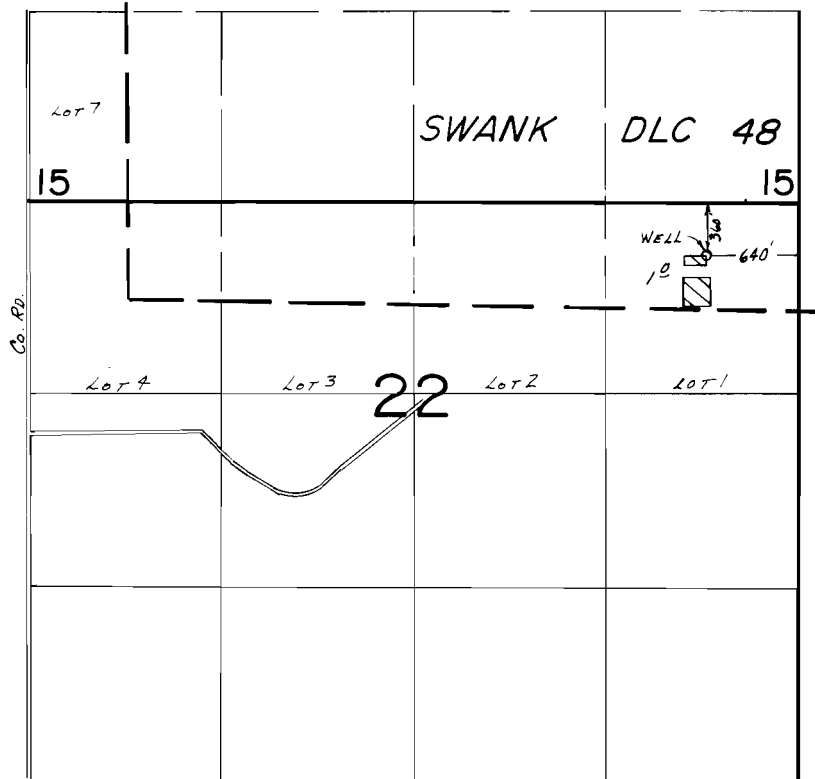

SCALE: 1"=1320'

FINAL PROOF SURVEY

UNDER

Application No. G-7047 Permit No. G-6534
IN NAME OF

POMEROY G. SORUM

Surveyed July 19 1984, by B.W. BISHOP