



G-6564
57127

T.3S., R.26E., W.M.

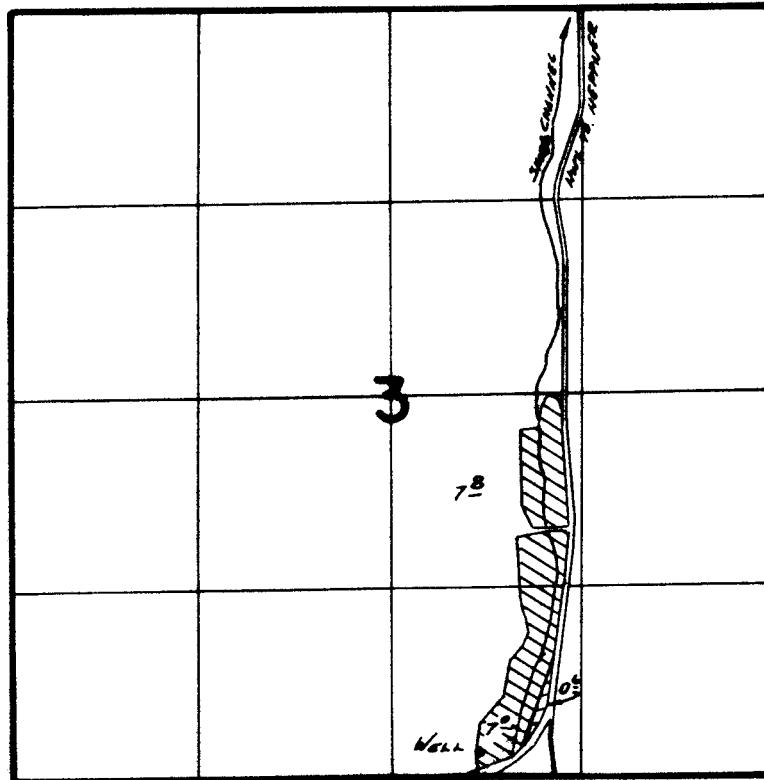

Well Loc: 170' N. + 2010' W. FROM SE COR. SEC 3

FINAL PROOF SURVEY
UNDER

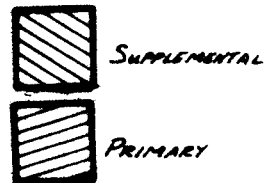

Application No. **G:7096** Permit No. **G:6564**
IN NAME OF

CHARLES MARCEL JONES

Surveyed March...th. 1982, by *V.L. Church*

PTS-1982-PA
478-114