


T. 39 S., R. 8 W., W. M.

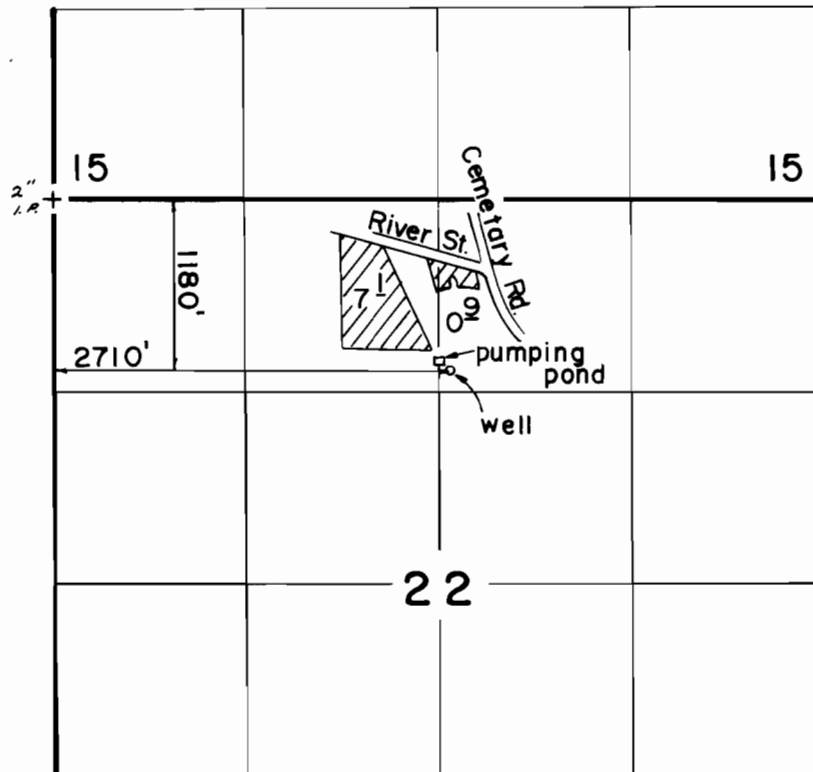

Scale: 1" = 1320'

FINAL PROOF SURVEY
UNDER

Application No. **G-7179** Permit No. **G-6614**
IN NAME OF

JOSEPHINE.....COUNTY.....SCHOOL.....DISTRICT

Surveyed **APR...1...** 1986, by **B. S. JAMES**.