


T. 11S. R. 2W. W. M

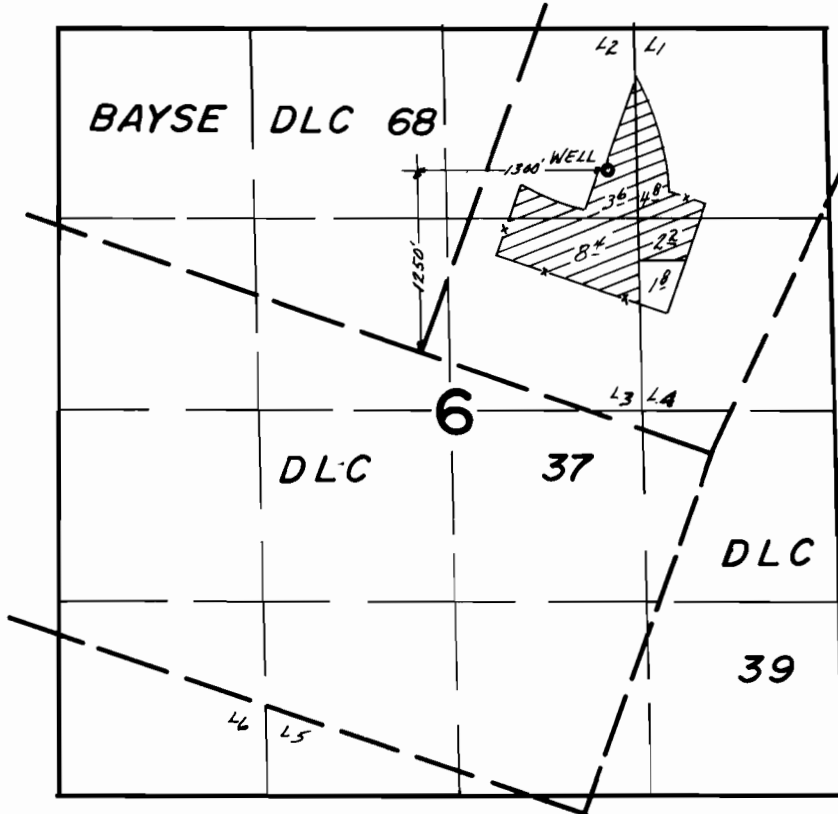

FINAL PROOF SURVEY UNDER

Application No. G-7193. Permit No. G-6624...
IN NAME OF

.....SCHELER...CORPORATION.....

Surveyed July...5... 1979., by S.C. BROWN.....