


T.3S., R.2W., W.M.

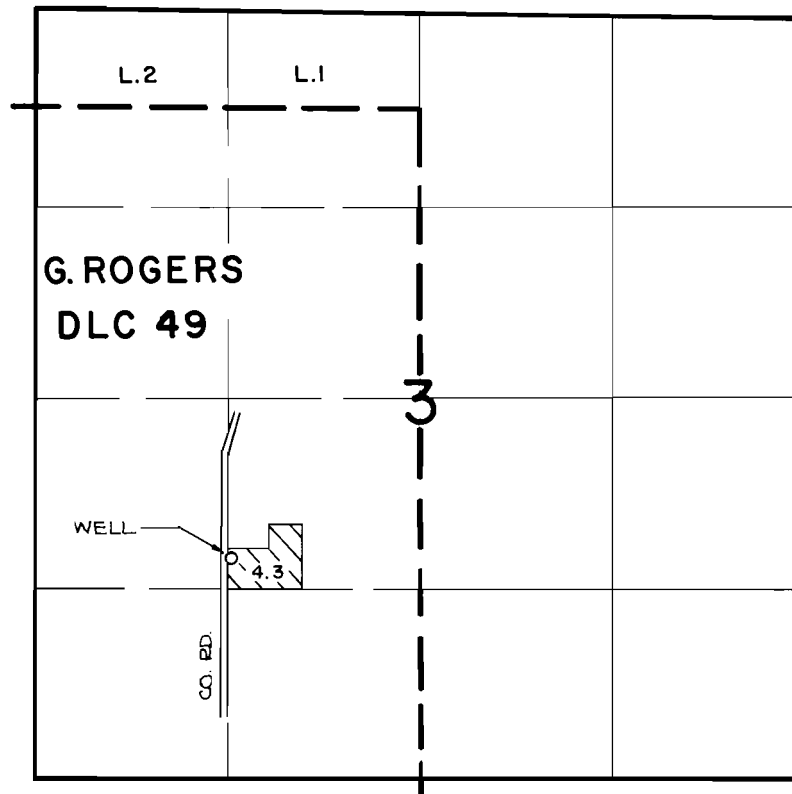

WELL LOCATION: 1530 FT. N. AND 1310 FT. W. FROM THE S. 1/4 CORNER



SCALE: 4" = 1 MILE

FINAL PROOF SURVEY
UNDER

Application No. ~~G-7293~~ Permit No. ~~G-6745~~....
IN NAME OF

.....GRANT W. PERRY.....

Surveyed NOV. 9, 1984, by *P. Patten*.....