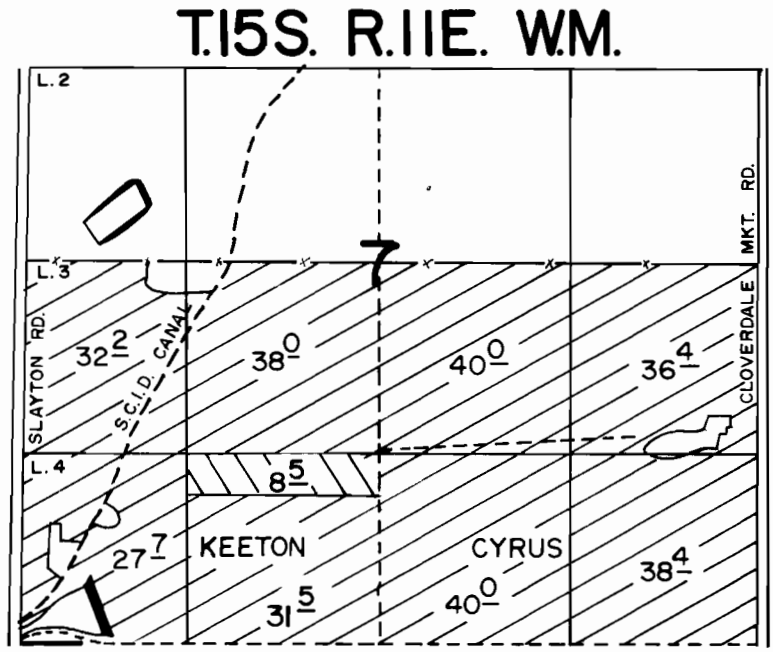

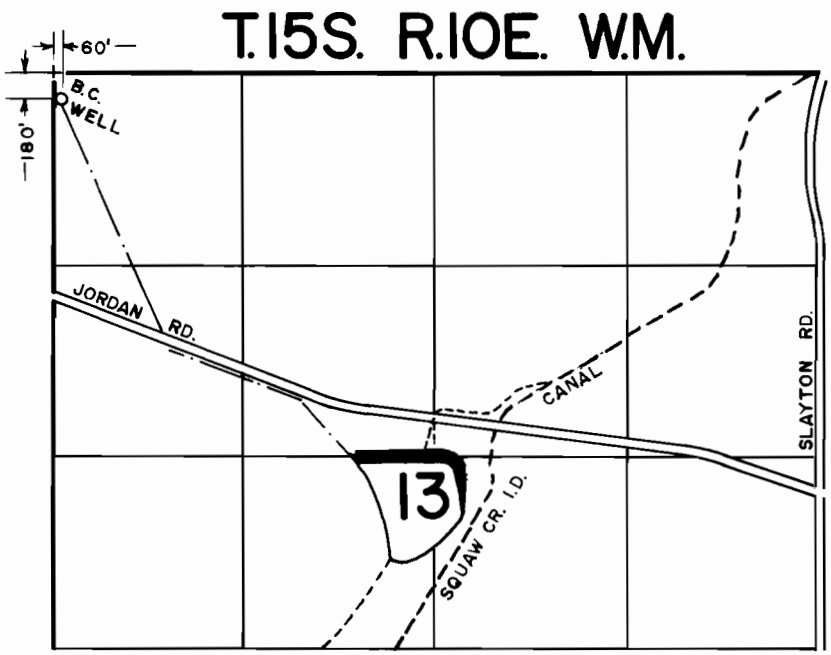

FINAL PROOF SURVEY

UNDER

Application No. G-7275 Permit No. G-6857

IN NAME OF

ARLAND T. KEETON & KEITH CYRUS

Surveyed APR. 29 1980, by L.H. NUNN

SCID 15-10-14 & 15-11-17