



G-6866
57136

T. 2N., R. 33E., W. M.

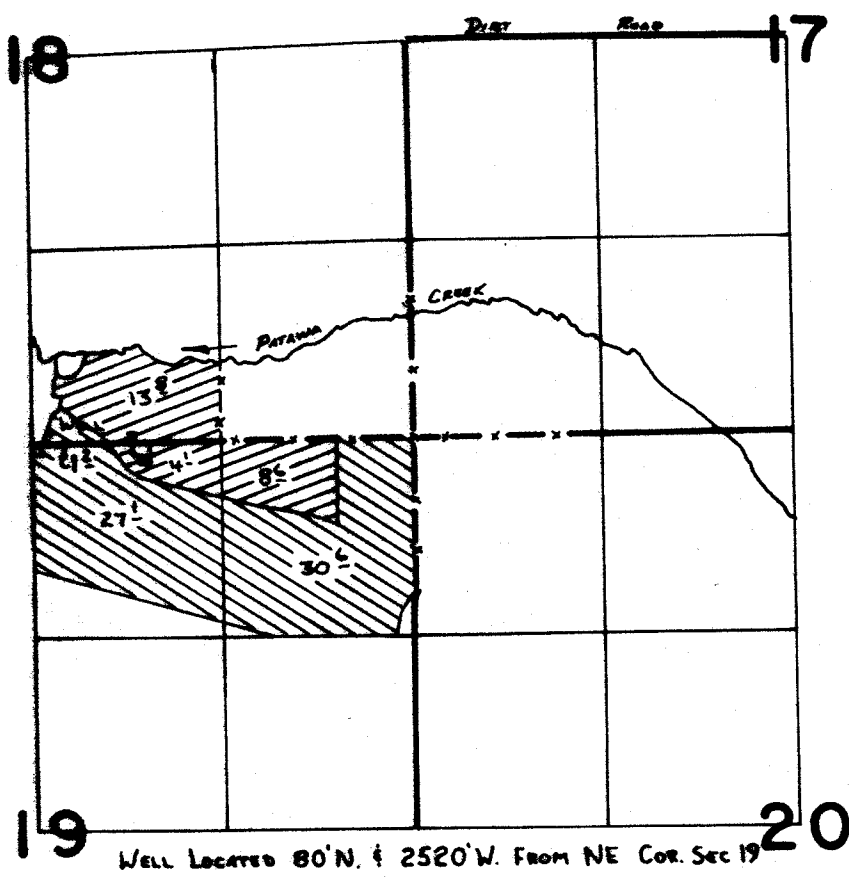


 SCALE: 1" = 1320'

 PRIMARY
  SUPPLEMENTAL

FINAL PROOF SURVEY
UNDER

Application No. **G:7339** Permit No. **G:6866**
IN NAME OF

.....**C. C. CURL, JR.**.....

Surveyed ..12..15..... 19.84., by **Y. L. Church**.....