


T.1N., R.12E., W.M.

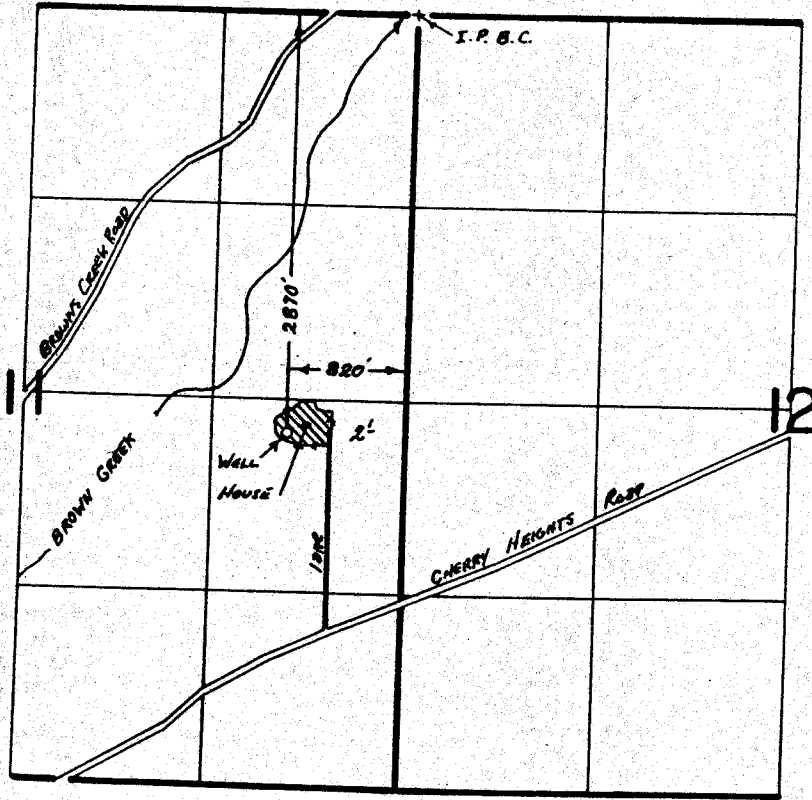

FINAL PROOF SURVEY UNDER

Application No. G-7427. Permit No. G-6926.
IN NAME OF

LAWRENCE E. MARSH

Surveyed Jan. 12, 1983, by T. J. Paul