


T. 39 S., R. 1 E., W. M.

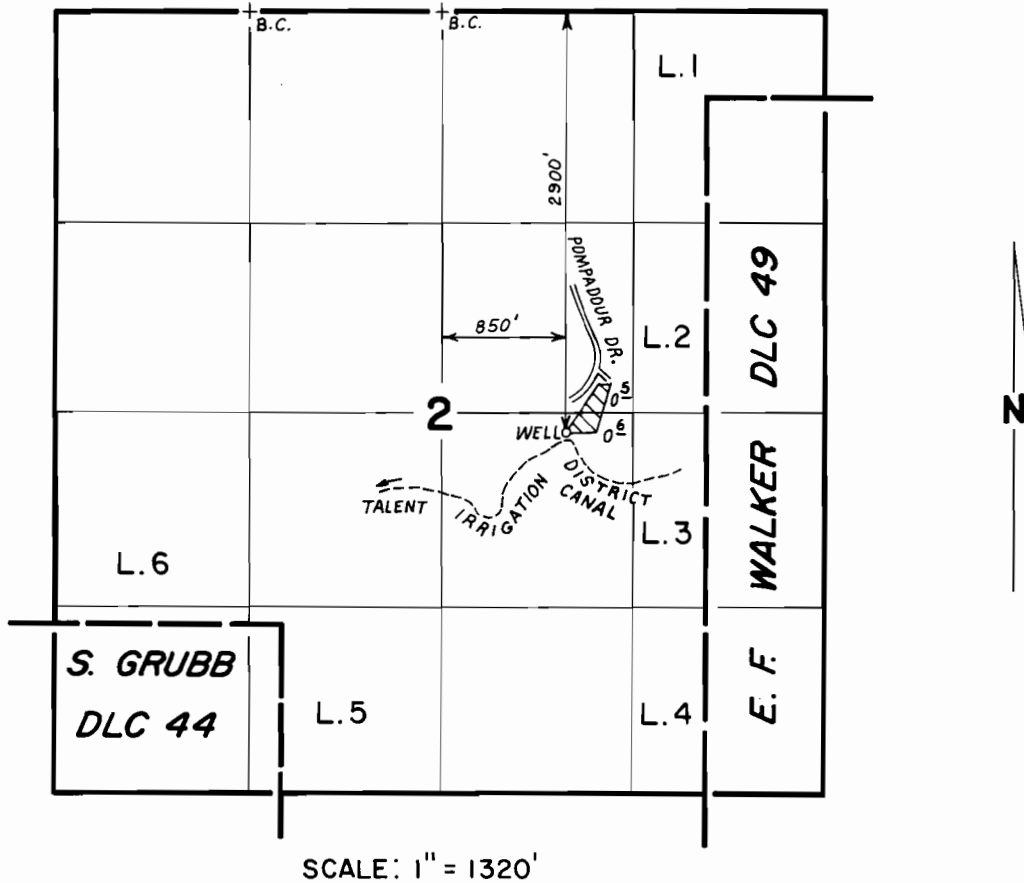

FINAL PROOF SURVEY UNDER

Application No. G-7529 Permit No. G-7001
IN NAME OF

SAM B. DAVIS

Surveyed JUNE 7, 1984, by B.S. JAMES