


G-7004
57143

T. 1S., R. 24E., W.M.

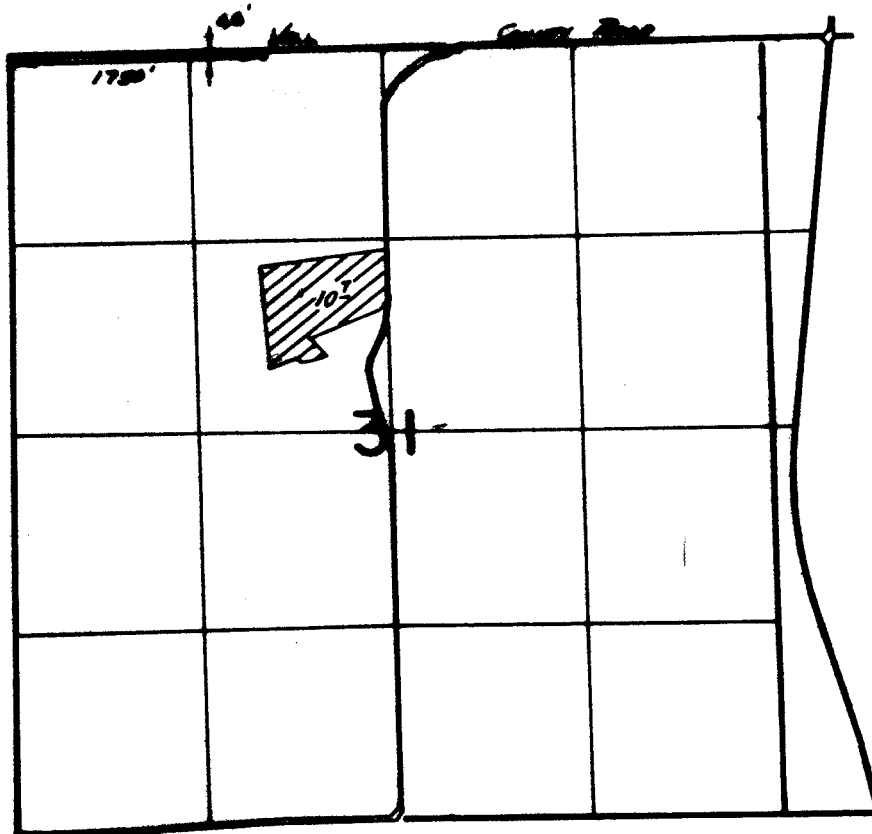

FINAL PROOF SURVEY
UNDER

Application No. G-7532 Permit No. G-7004
IN NAME OF

EARL W. & RIKKA A. TEWS.

Surveyed OCT. 11 1982, by K.L. CURRAN