


T.16S.,R.4W.,W.M.

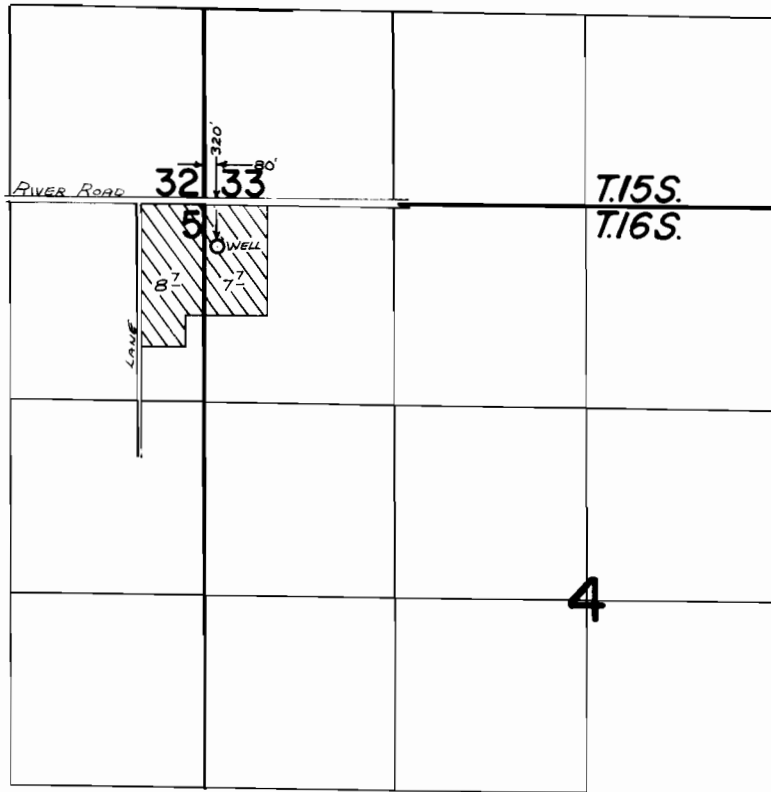

FINAL PROOF SURVEY UNDER

Application No. G-7604 Permit No. G-7040
IN NAME OF

CARL E. RUDER

Surveyed Sept. 16, 1981, by S. C. BROWN