


P. G-7064  
57145

T. 2N., R. 18E., W. M.

SCALE: 1"=1320'

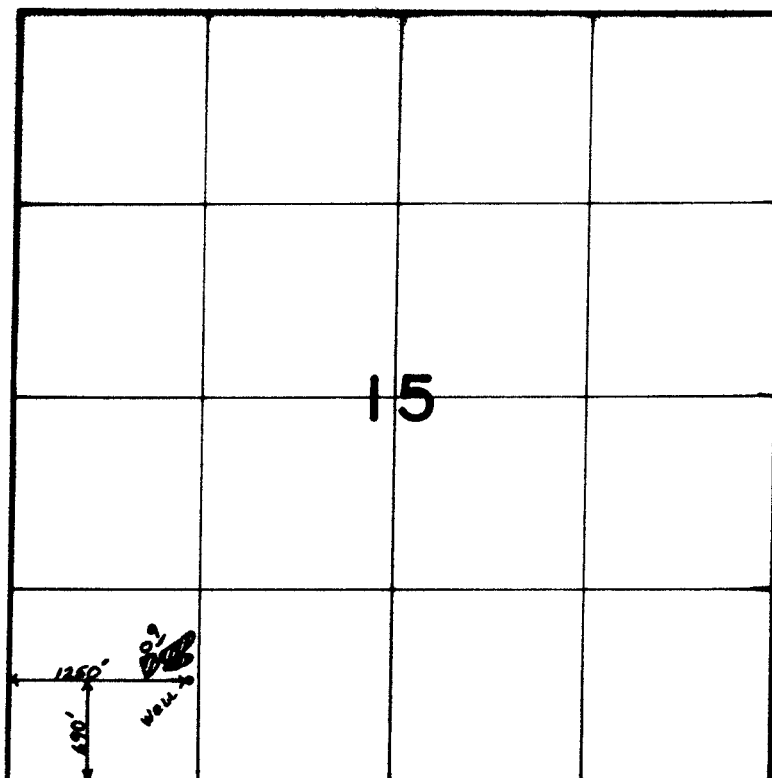

**FINAL PROOF SURVEY**  
UNDER

Application No. G-7618.. Permit No. G-7064....  
IN NAME OF

**JAMES WEIR MEMORIAL-BIGLOW DIST.**

Surveyed MAY. 8..... 1931.. by V. L. CHURCH.....