


T.10S. R.3W. W.M.

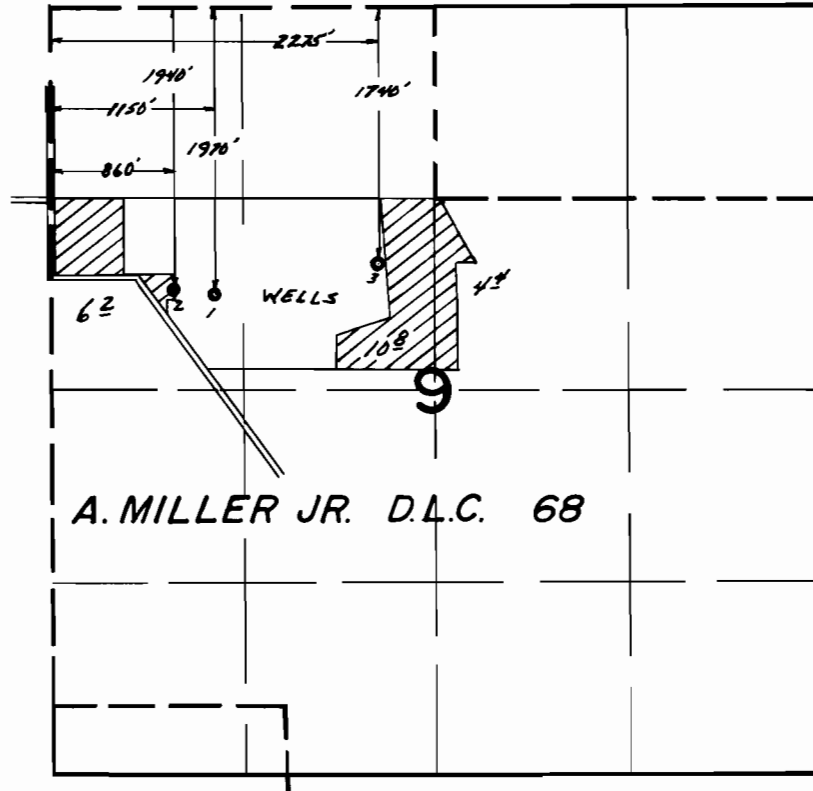

**FINAL PROOF SURVEY**  
UNDER

Application No. G-7687. Permit No. G-7113.....  
IN NAME OF

.....WELDON FAMILY TRUST.....

Surveyed April 29, 1979., by S.C.BROWN.....