


14 12E

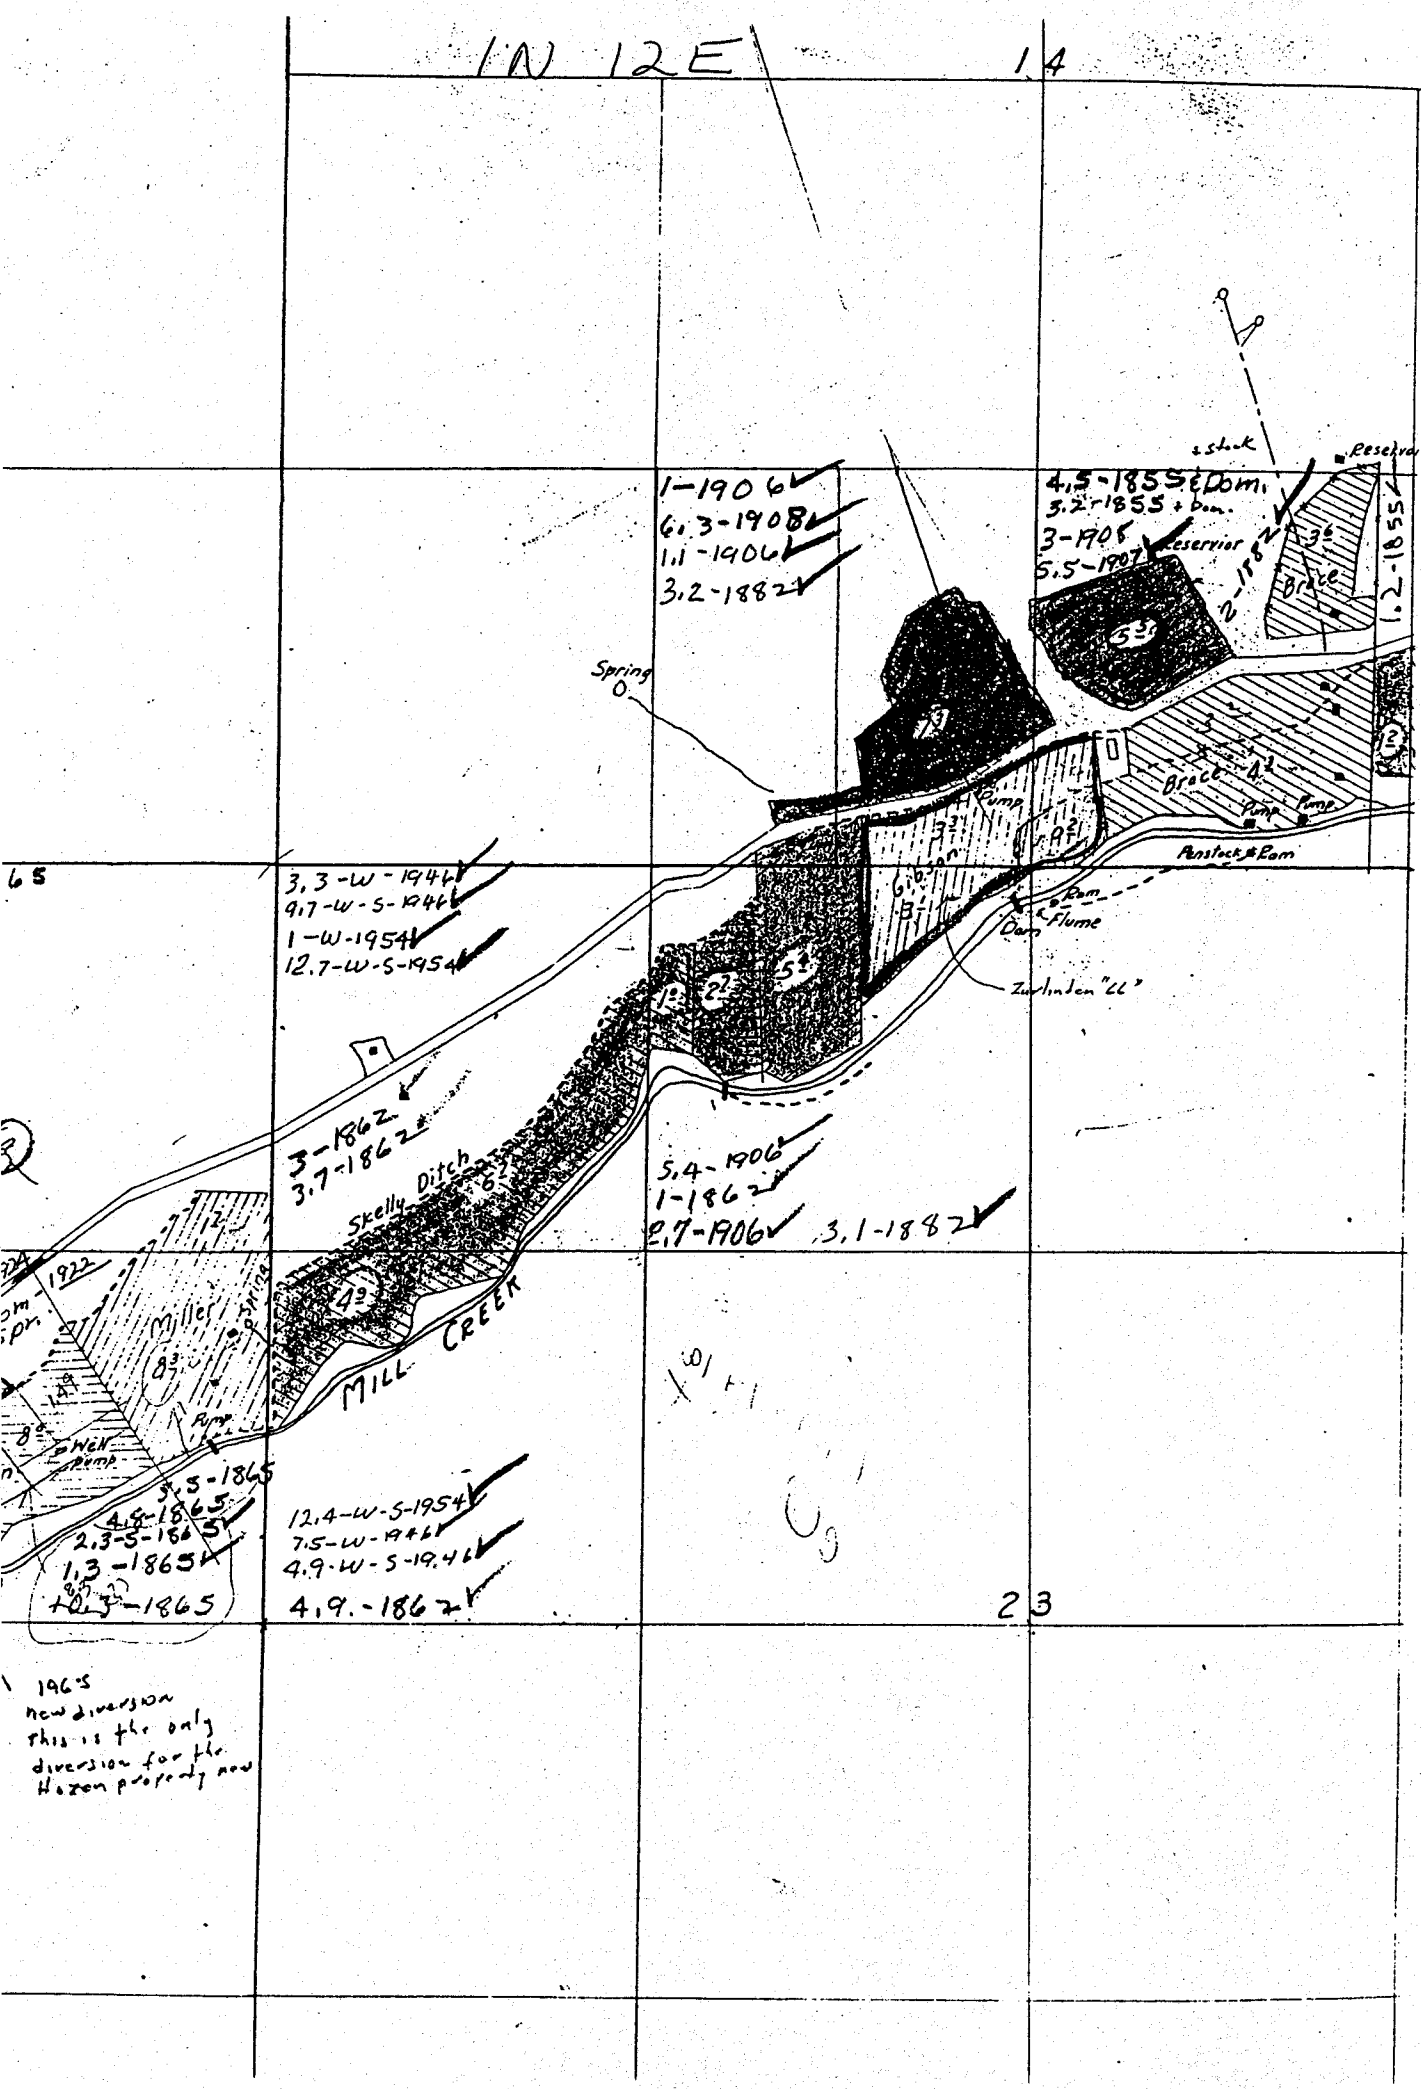

1965
 new diversion
 this is the only
 diversion for the
 Hazen property now