


G-7181
57151

T.39S. R.19E. W.M.

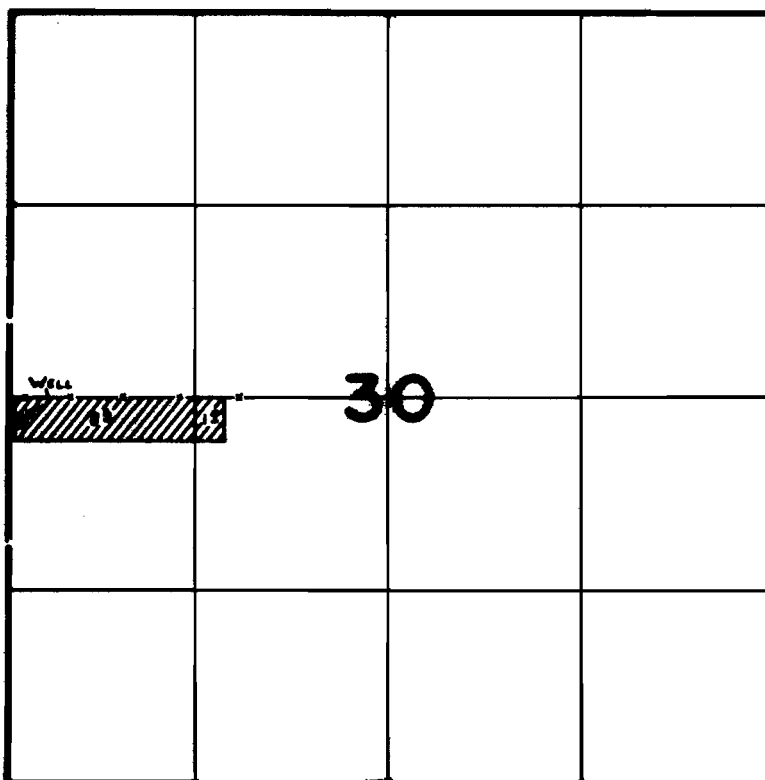

Well Loc: 170' S. & 80' E. fr. W. 1/4 Cor. Sec. 30.

FINAL PROOF SURVEY UNDER

Application No. G-7820 Permit No. G-7181.....
IN NAME OF

.....LAWRENCE H. PLATT.....

Surveyed June 10, 1980, by C. L. Hughes.....