


T15S. R10E. W.M.

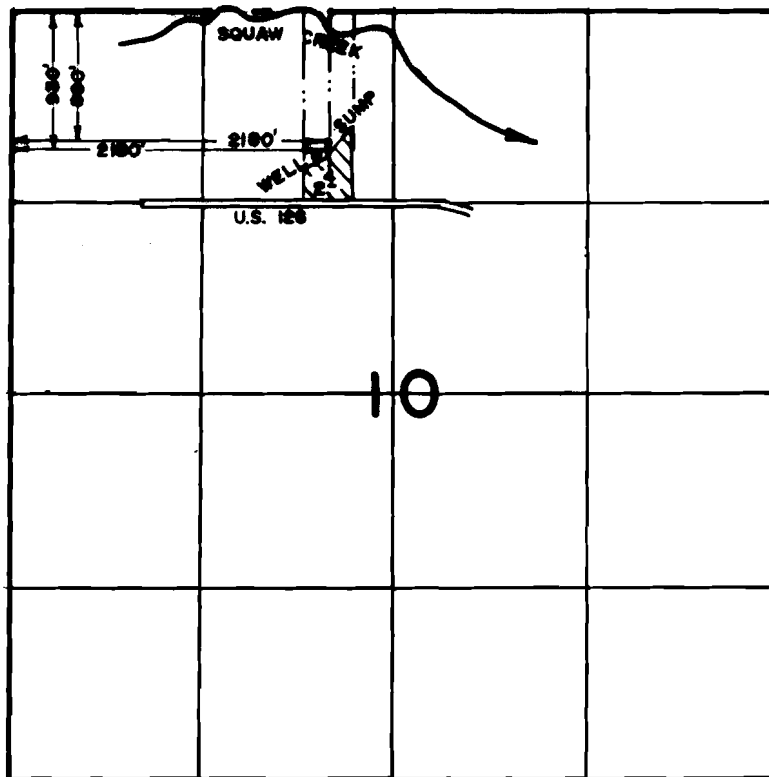

FINAL PROOF SURVEY UNDER

G-7554 G-7209 57152
 Application No. G-8675. Permit No. G-7959 57155
 IN NAME OF

..... LESTER & WILLARD CURTIS

Surveyed MAY 23, 1990., by L.H. NUNN.....

RECEIVED

DATE 6-3-88

WATER MASTER DISTRICT #11

BY SMS

G7959
G7209