


# T.15S. R.10E. W.M.

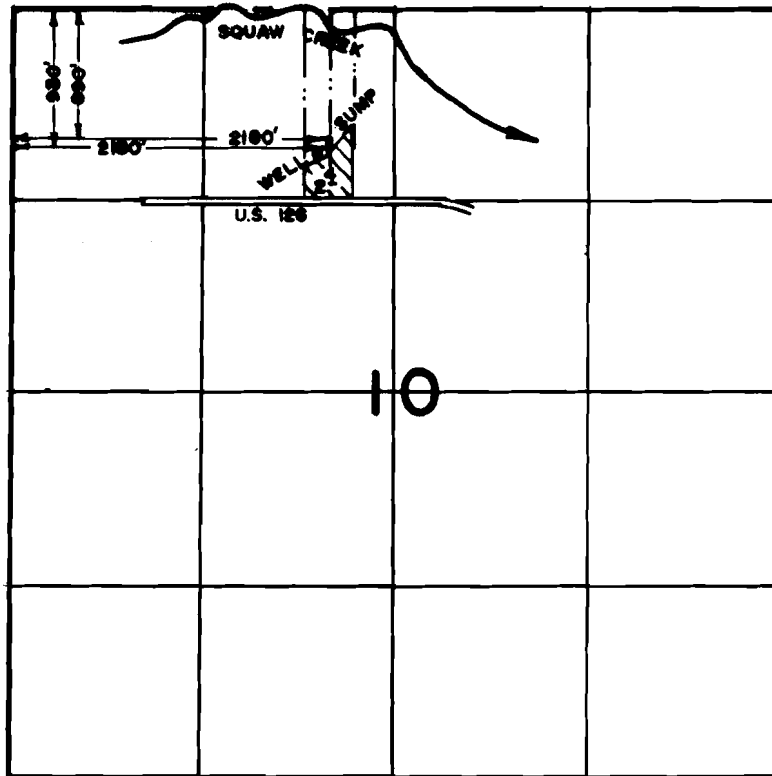

## FINAL PROOF SURVEY UNDER

Application No. G-7554      G-7209 <sup>57152</sup>  
 G-8675      Permit No. G-7959 <sup>57155</sup>  
 IN NAME OF

..... LESTER & WILLARD CURTIS .....

Surveyed MAY 23, 1990., by L.H. NUNN.....

RECEIVED

DATE 6-3-88

WATER MASTER DISTRICT #11

BY *SMJ*

G 7959  
G 7209