


T. 38 S., R. 7 W., W. M.

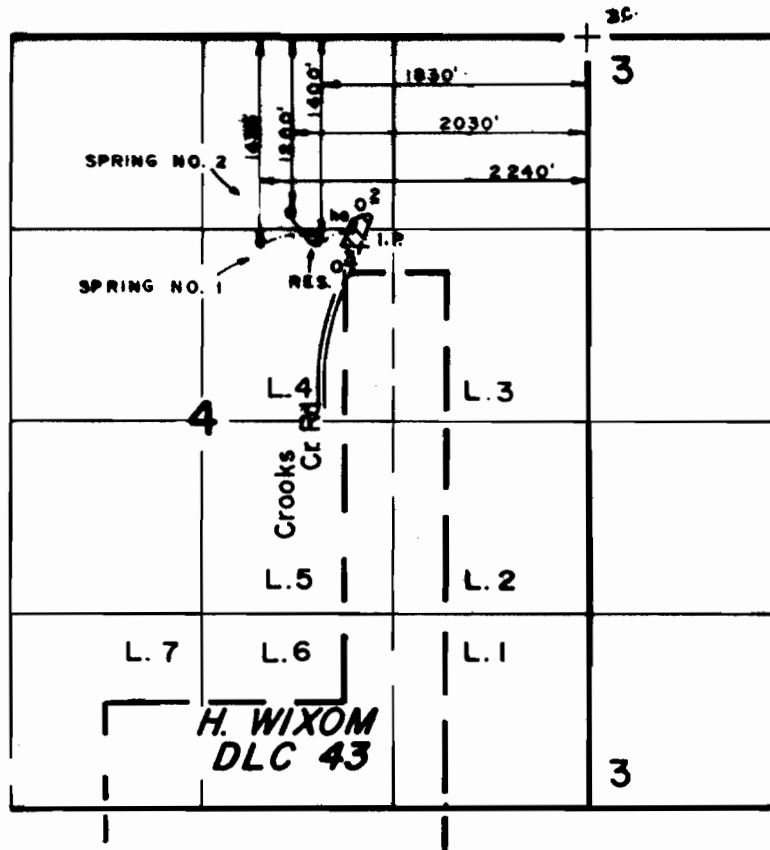

Scale: 1" = 1320'

**FINAL PROOF SURVEY**

UNDER

59954

45062

R-64554

R-8606

Application No. ~~64555~~ Permit No. ~~47432~~

IN NAME OF

.....S.T.E.V.E.....I.L.L.I.N.G.S.W.O.R.T.H.....

Surveyed JUN. 19. 1986, by R. S. JAMES.