


T. 38 S., R. 7 W., W. M.

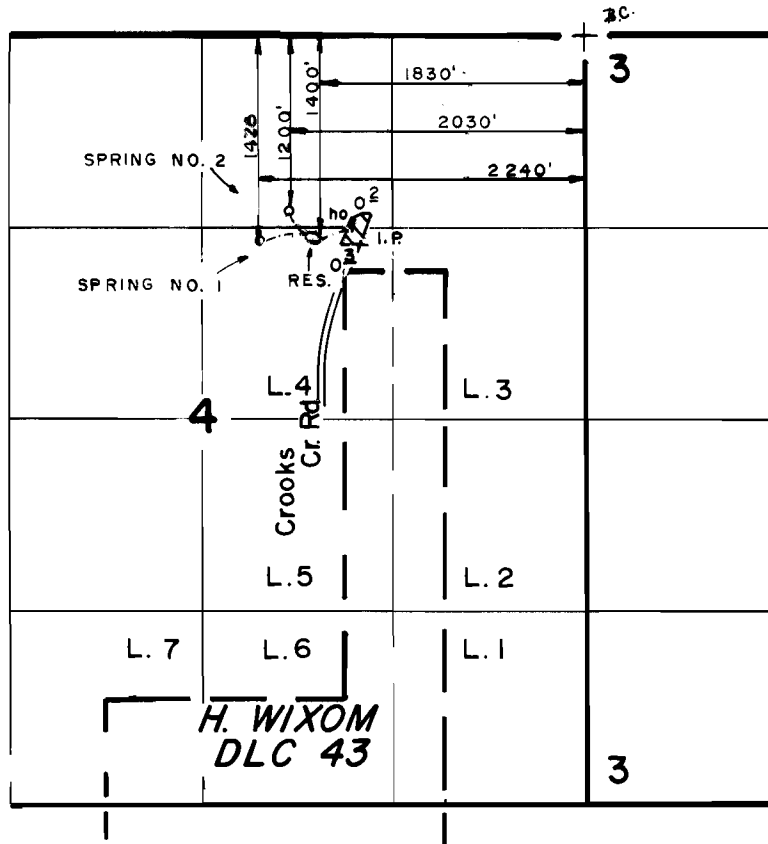

Scale: 1"=1320'

FINAL PROOF SURVEY

UNDER

59954

45062

R-64554

R-8606

Application No. 64555 Permit No. 47432

IN NAME OF

.....S.T.E.V.E.....I.L.L.I.N.G.S.W.O.R.T.H.....

Surveyed JUN. 19. 1986, by B. S. JAMES.