T. 38 S., R. 7 W., W. M.

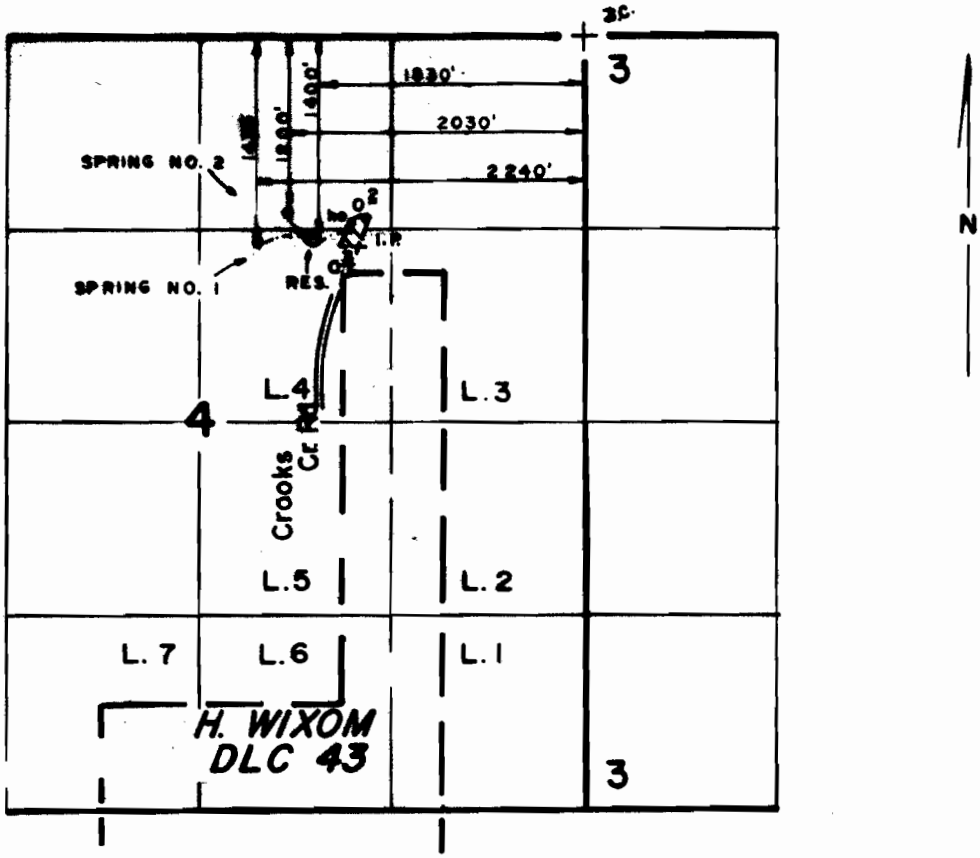

Scale: 1" = 1320'

FINAL PROOF SURVEY

UNDER

59954 45062

R-64554 R-8606

Application No. 64555 Permit No. 47432

IN NAME OF

STEVE ILLINGSWORTH

Surveyed JUN. 19 1986, by B. S. JAMES