


T. 37 S., R. 6 W., W.M.

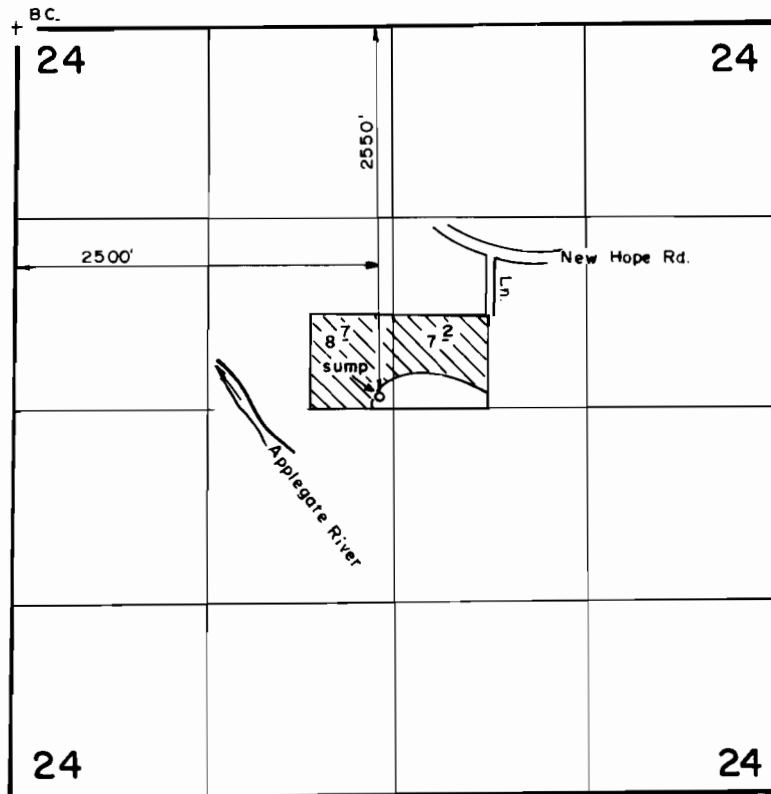

Scale: 1" = 1320'

**FINAL PROOF SURVEY**  
UNDER

Application No. G-6281 Permit No. G-5912  
IN NAME OF

SAMUAL MARKS & HARRY J. LA CHANCE, SR.

Surveyed JUL. 29 1986, by B. S. JAMES