


T. 4N., R. 2W., W.M.

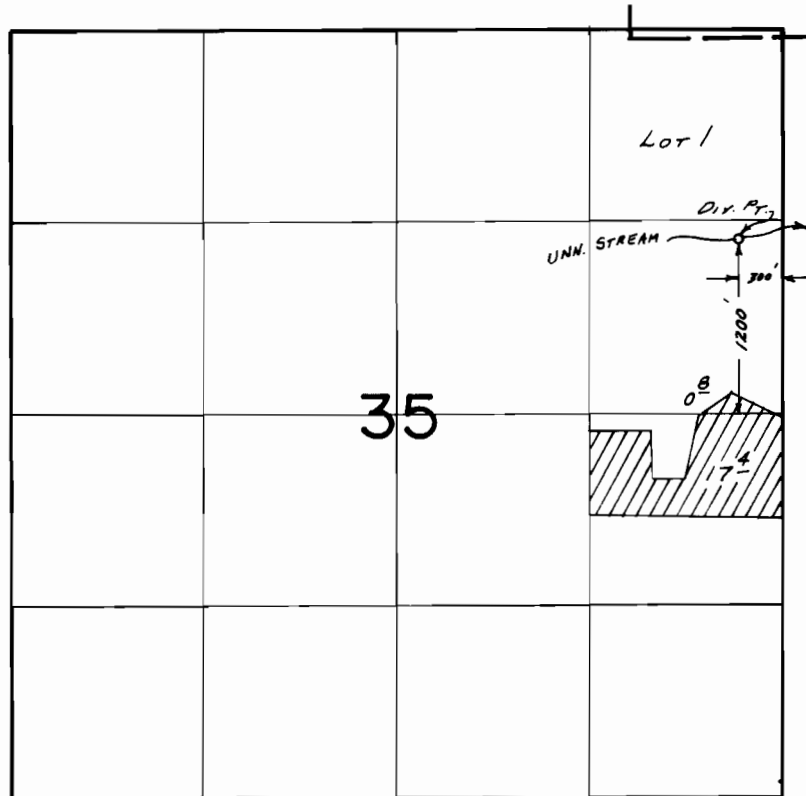

FINAL PROOF SURVEY
UNDER

Application No. 41063 Permit No. 30598.....
IN NAME OF

AL GRABHORN.....

Surveyed APR. 9 1980, by R.G. MUCKEN.....