


T.16S. R.4W., W.M.

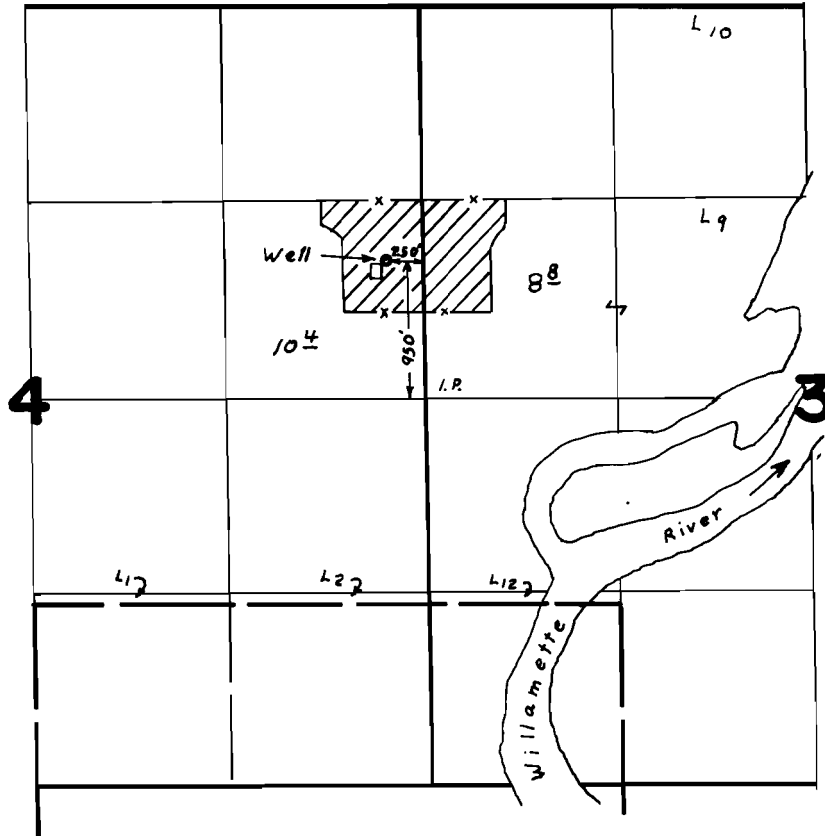

FINAL PROOF SURVEY UNDER

Application No. G-5206. Permit No. G-5071
IN NAME OF

ROBERT C. & DELLA M. GRIMES

Surveyed APR. 27 1978, by J.S. DONALDSON
Sept. 16 1981 S C BROWN