


T. 14S., R. 4W., W.M.

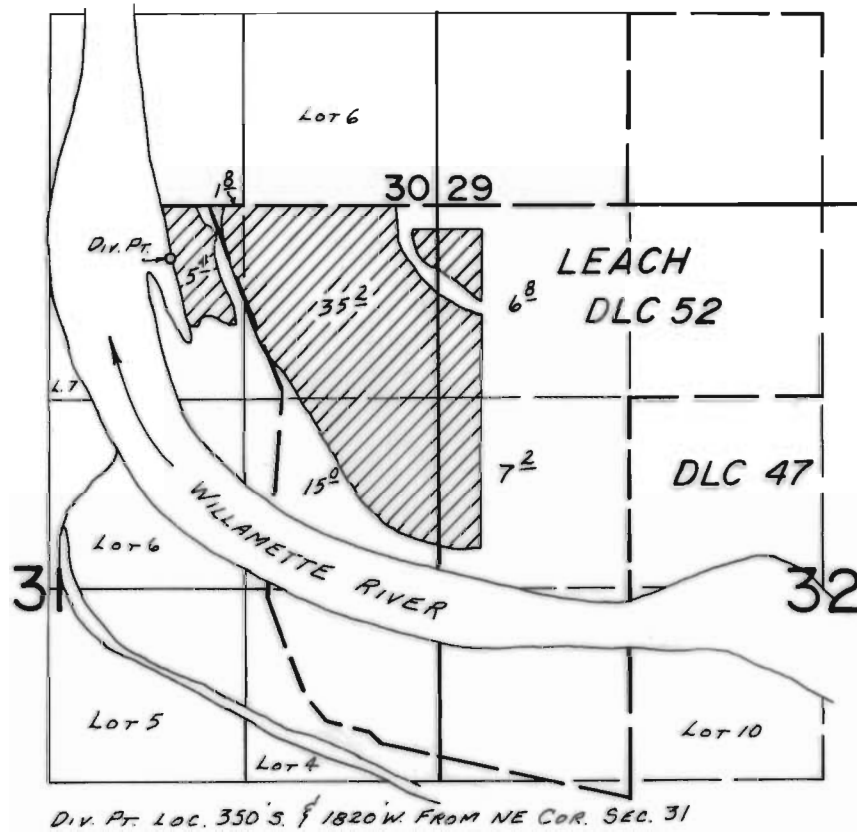

FINAL PROOF SURVEY
UNDER

Application No. 47722.. Permit No. 35798.....
IN NAME OF

.....SAM & VELMA FARRUGGIA.....

Surveyed JULY 2, 1980, by S.C. BROWN.....