# T.2S.R.1W.W.M

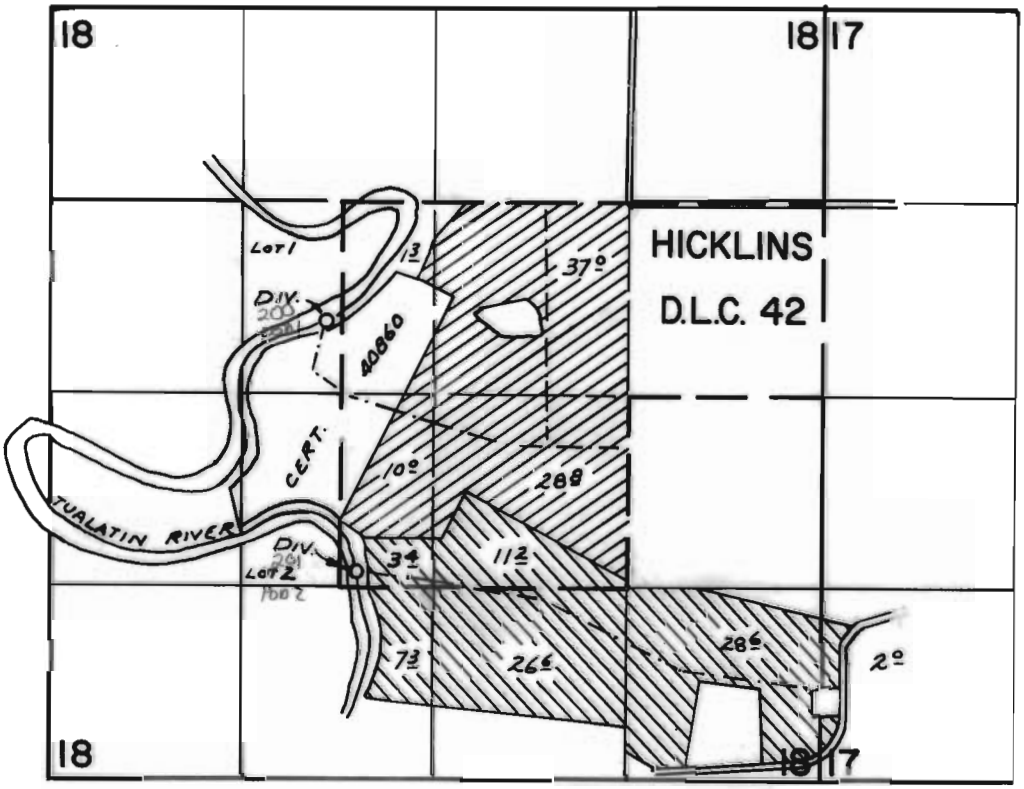


CERT. 43946 → DENNIS  PATTIE

DIV. PTS. LOC: 810' S. & 2060' W ; 2530' S. & 1840' W, BOTH FROM N.E. COR. SW¼ NE¼ SEC. 18

## FINAL PROOF SURVEY

UNDER

Application No. 48082 Permit No. 36063

IN NAME OF

DANIEL DENNIS - HUGH L. & LUCILLE W. PATTIE

Surveyed OCT. 6, 1975, by D. HORBY
OCT. 8, 1976
JULY 7, 1977
JAN. 15, 1980 R. G. MUCKEN

1975-E & DBS-ILL-251