


T. 2N., R. 2W., W.M.

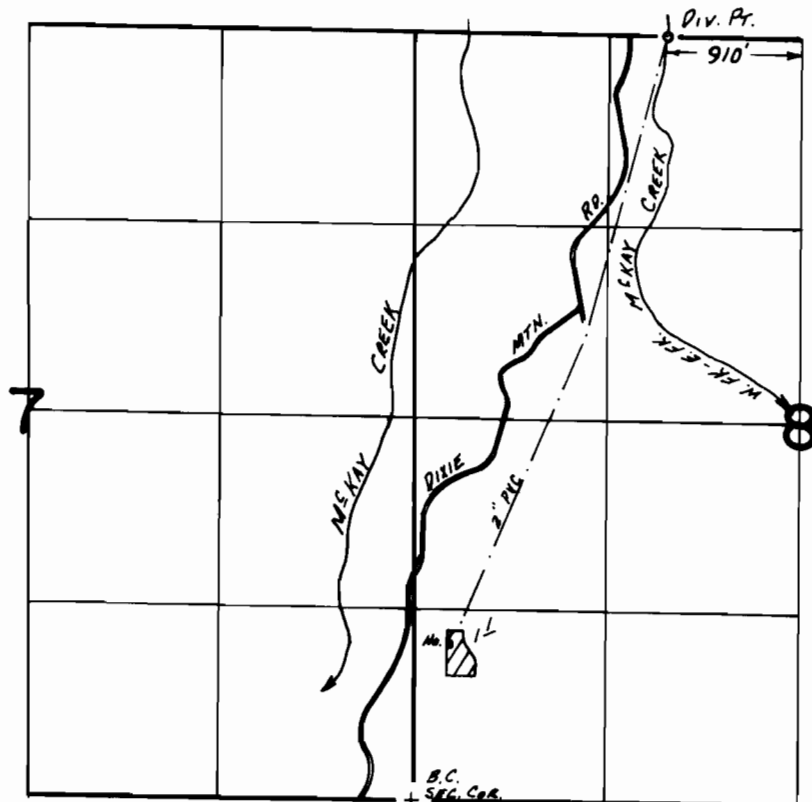

FINAL PROOF SURVEY

UNDER

Application No. 48012..... Permit No. 36171.....
IN NAME OF

DONALD J. & OLGA E. LOGAN

Surveyed JULY 22, 1980, by R.G. MUCKEN.....

DFR-2D-76
BWA