


P-36587  
C-57171

T.10S.,R.29E.,W.M.

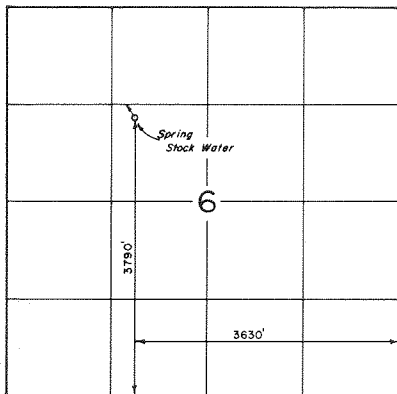

**FINAL PROOF SURVEY**  
UNDER

Application No. 48805 Permit No. 36587  
IN NAME OF

RICHARD WILBURN

Surveyed OCT. 7, 1981, by *John J. ...*