


T. 33 S., R. 6 W., W.M.

Sec. 21

NE 1/4 NW 1/4

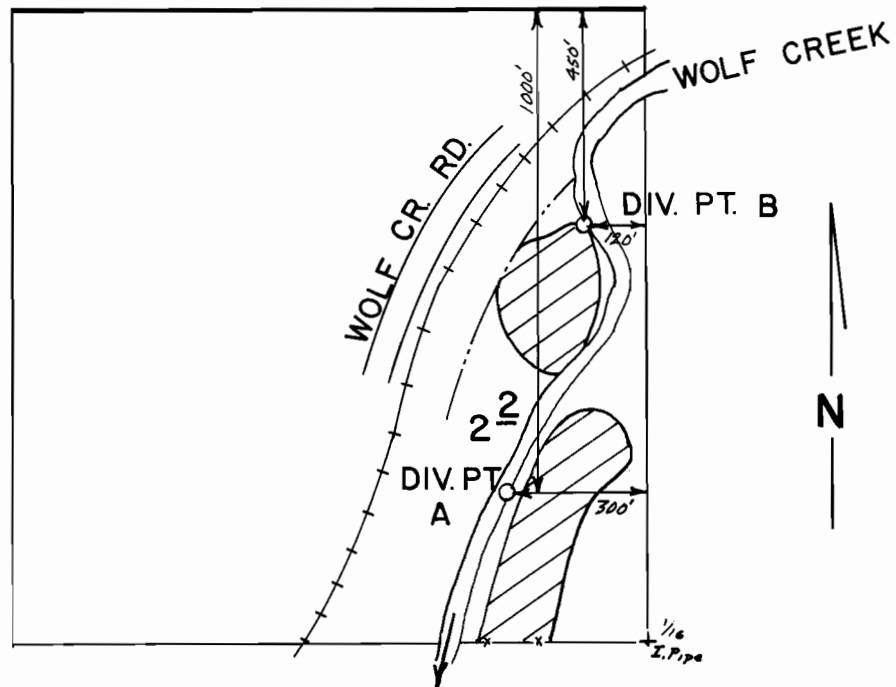

Scale 1" = 400'

**FINAL PROOF SURVEY**  
UNDER

Application No. 49260 Permit No. 36920  
IN NAME OF

BRUCE & SHARON GUERTS

Surveyed April 30, 1986, by B.S. JAMES