


T. 5 S., R. 6 W., W.M.

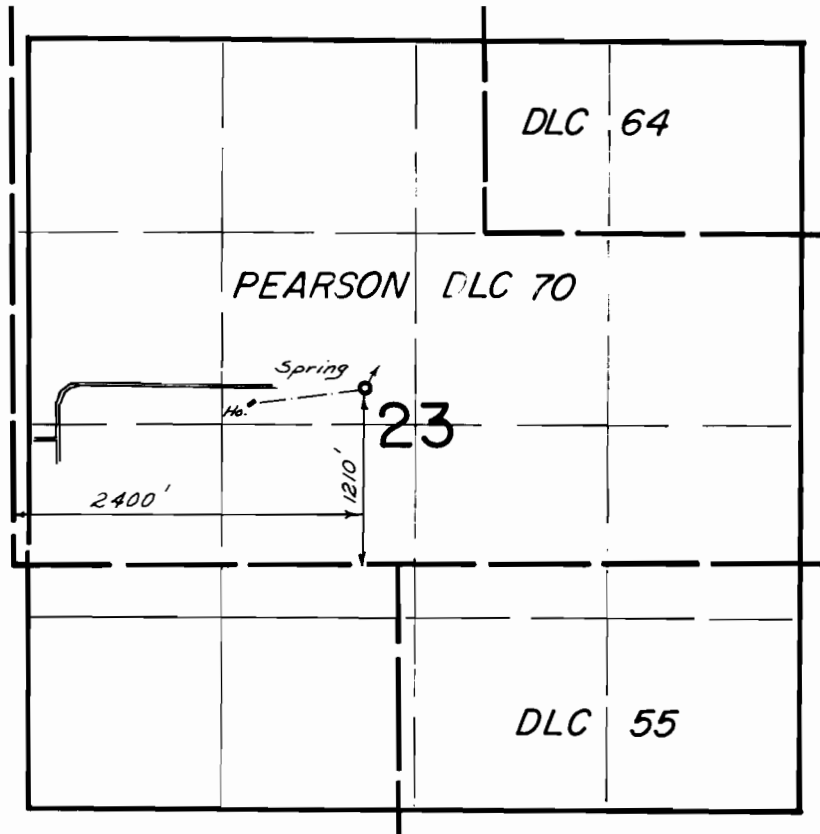

FINAL PROOF SURVEY
UNDER

Application No. 49789 Permit No. 37457
IN NAME OF

CLAYTON C. KOEHLER

Surveyed Aug 20, 1979, by J. C. Brown