


T. 37 S., R. 6 W., W.M.

Sec. 20

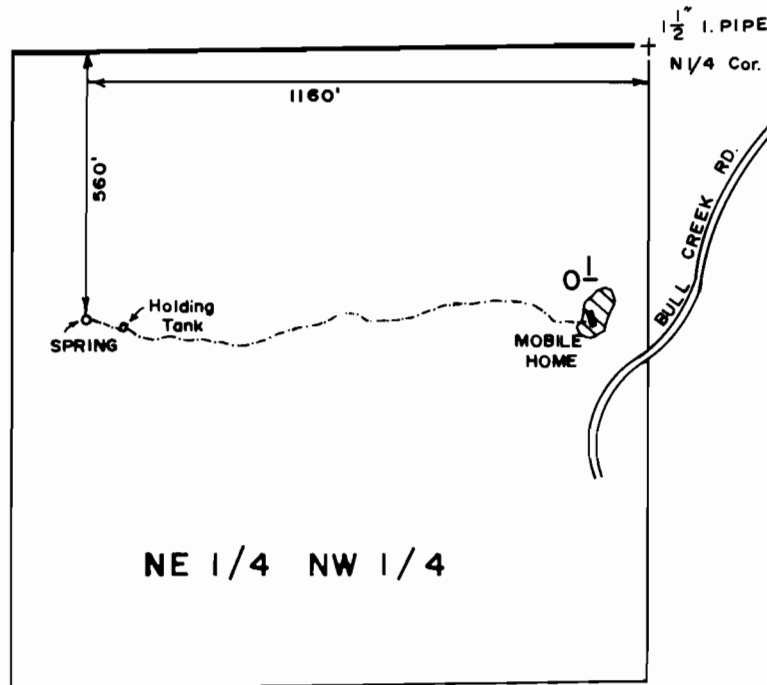

FINAL PROOF SURVEY
UNDER

Application No. **50580** Permit No. **37784**
IN NAME OF

ROBERT J. & BONNIE L. RUST

Surveyed **Oct. 21, 1983**, by **B.S. JAMES**

Scale 1" = 400'