


# T.16 S., R.9 W., W.M.

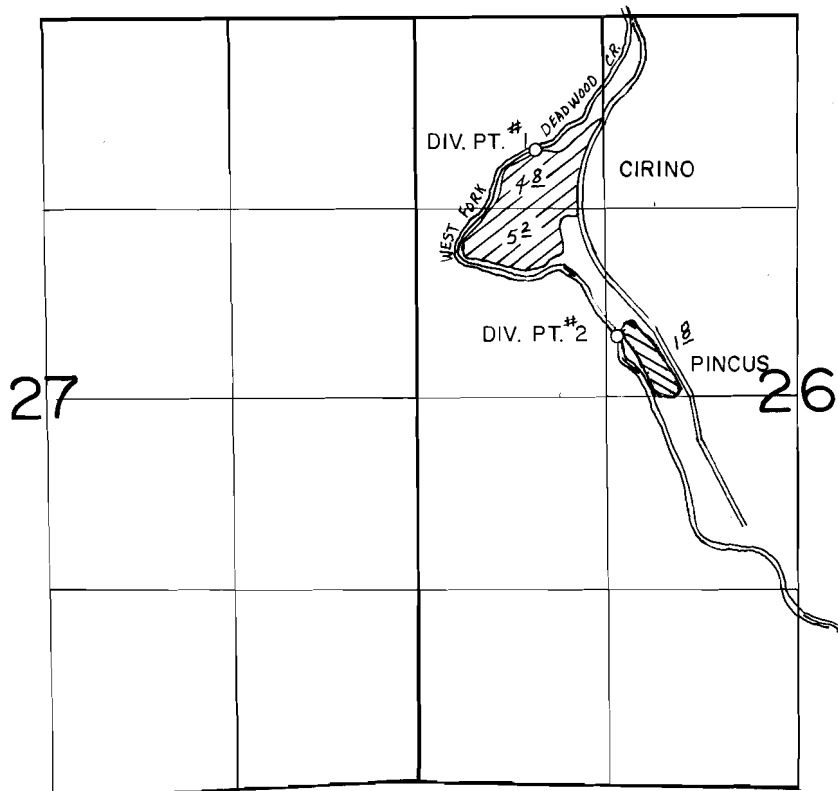

DIV. PT. #1 LOC.: 4380' N. & 1780' W., DIV. PT. #2 LOC.: 3060' N. & 1210' W. BOTH FROM THE S. 1/4 COR. SEC. 26.

SCALE: 1" = 1320'

## FINAL PROOF SURVEY UNDER

Application No. 50064 Permit No. 37926  
IN NAME OF

**AMY FRANCIS PINCUS & MARJORIE B. CIRINO**

Surveyed MAY 14 1980, by S.C. BROWN  
JUNE 6 1984, by P.R. PAGTER