


T.4S.,R.3W.,W.M.

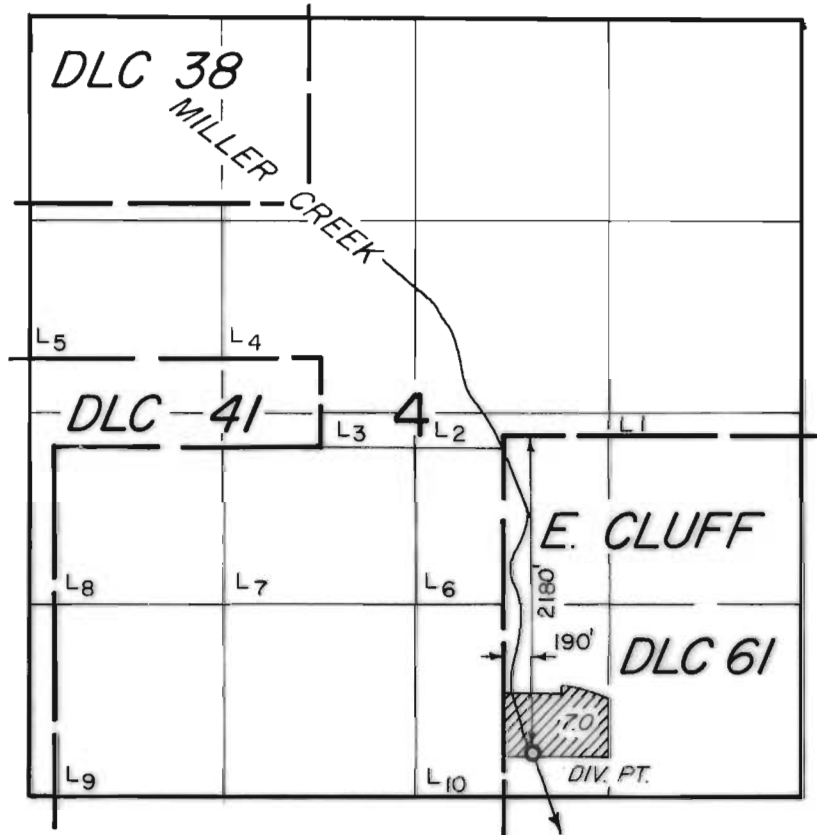

FINAL PROOF SURVEY
UNDER

Application No. 52682 Permit No. 37932
IN NAME OF

Darrell K. Jones

Surveyed MAY 10, 1979, by [Signature]