


9-3-1

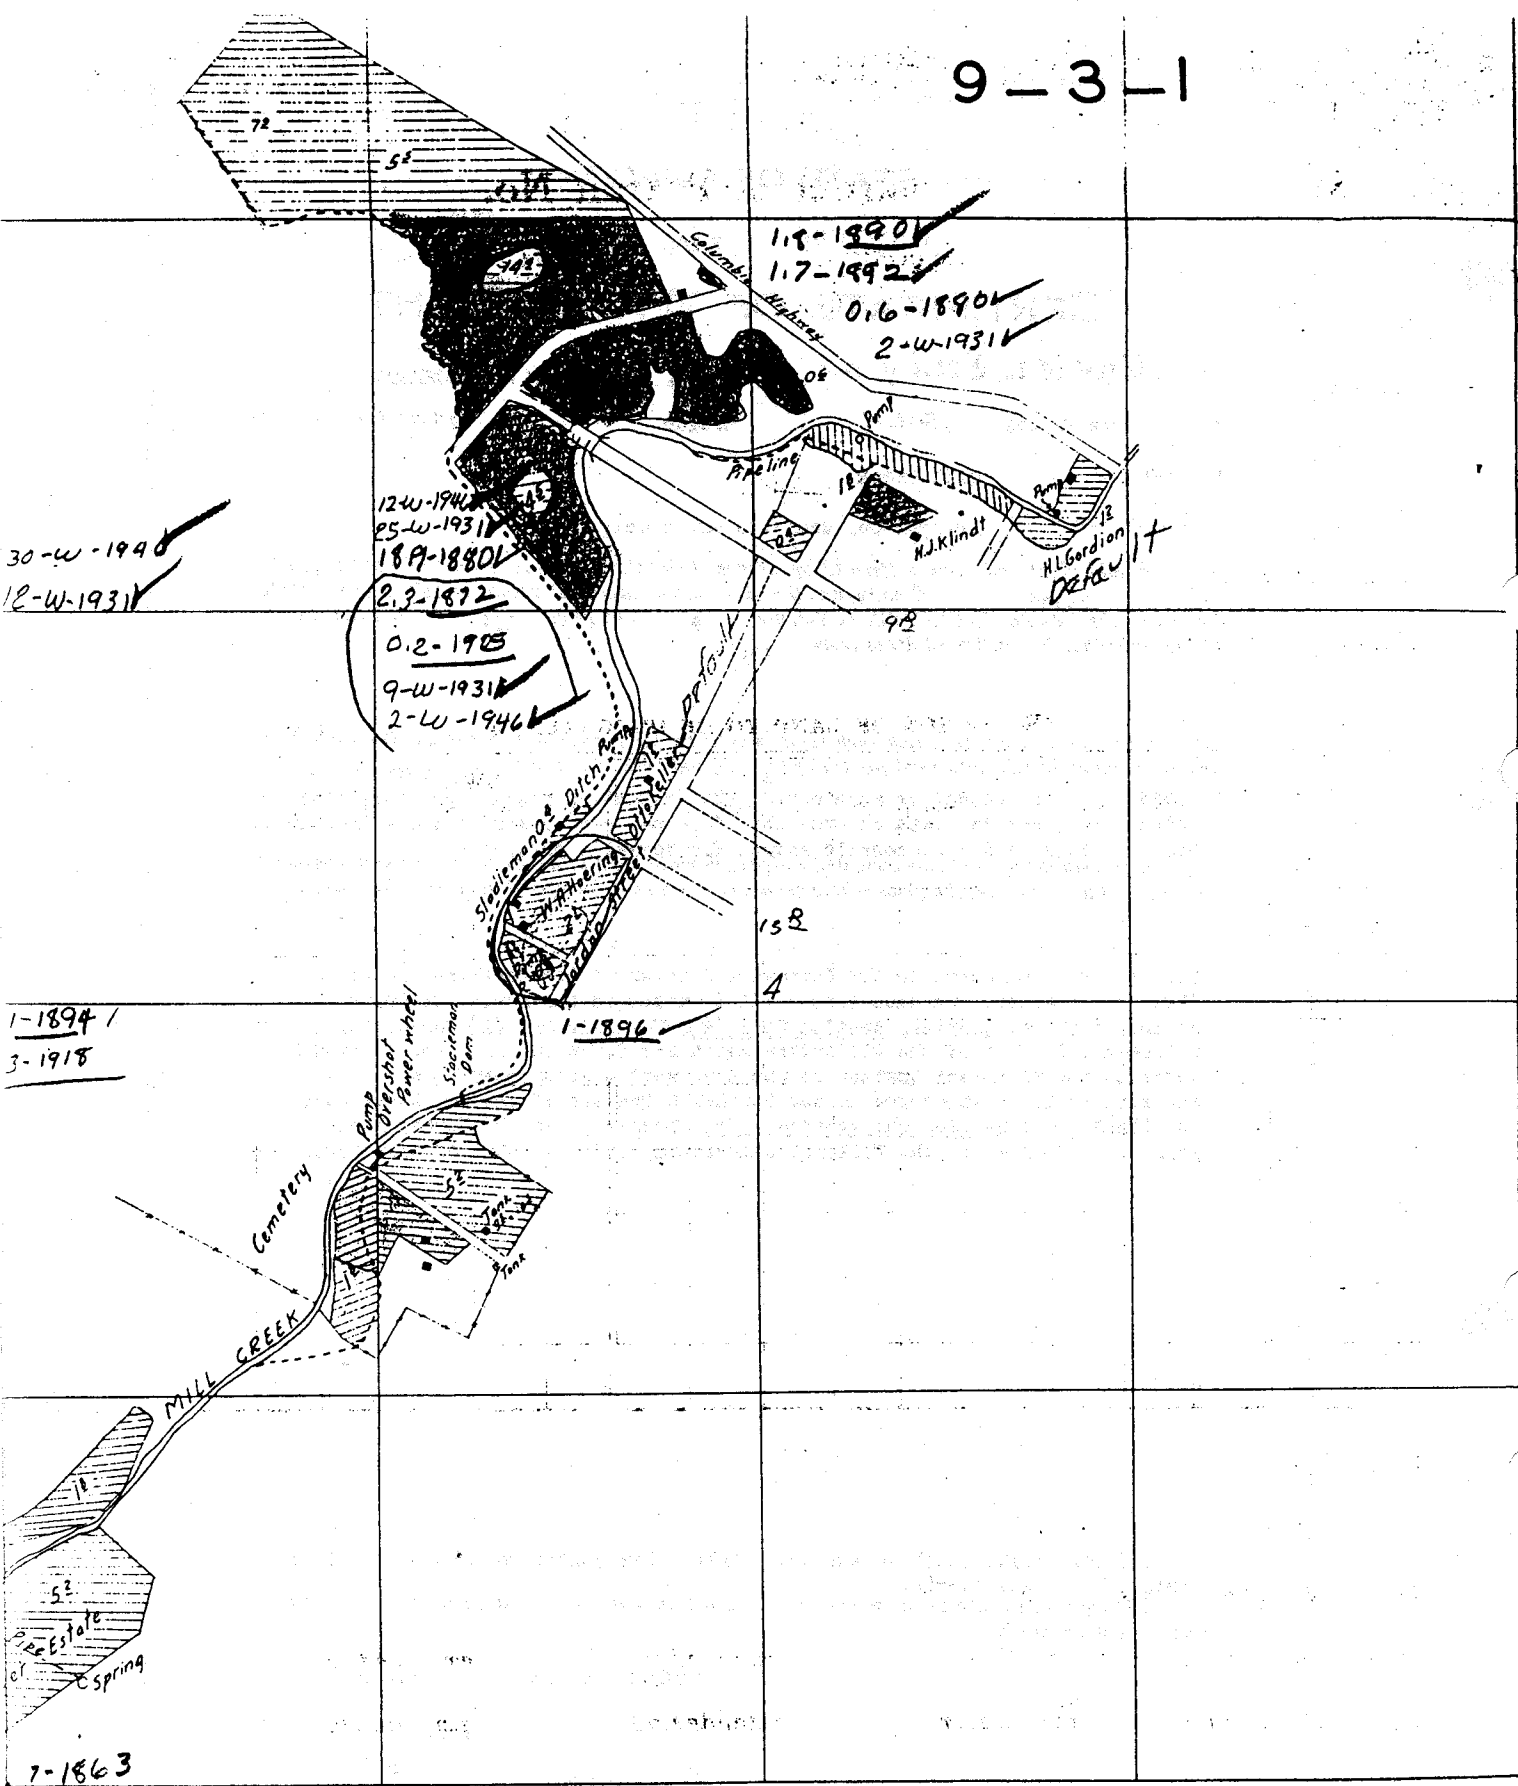

Copied from Mill Creek Adjudication Map