


T.20S. R.2W. W.M.

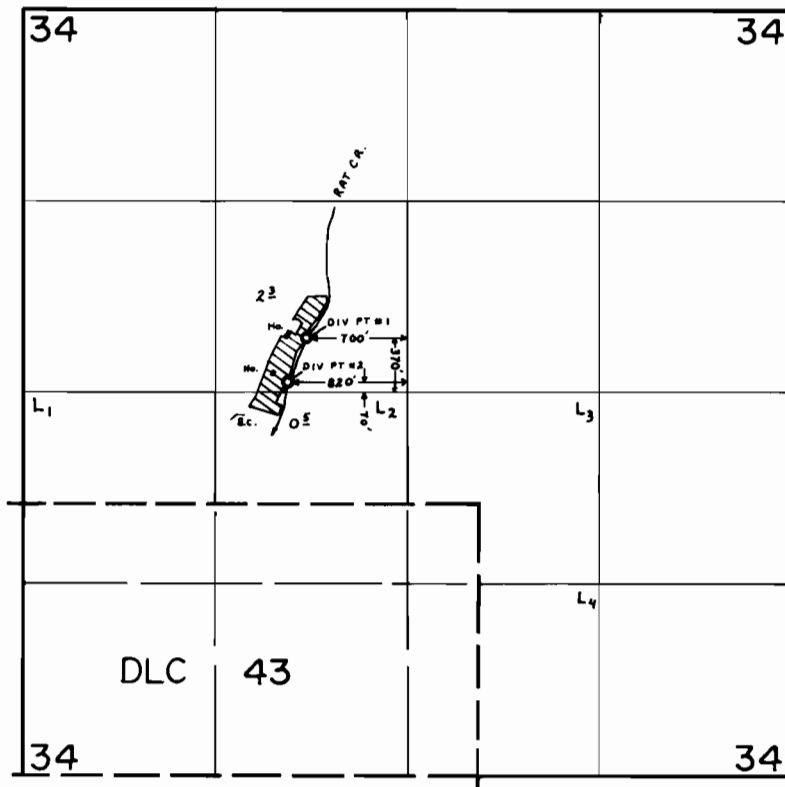

FINAL PROOF SURVEY
UNDER

Application No. 52032. Permit No. 39216.....
IN NAME OF

.....**HORNER**.....

Surveyed June 12, 1980, by C.L. Hughes.....