


T. 2 & 3 S., R. 2 W., W.M.

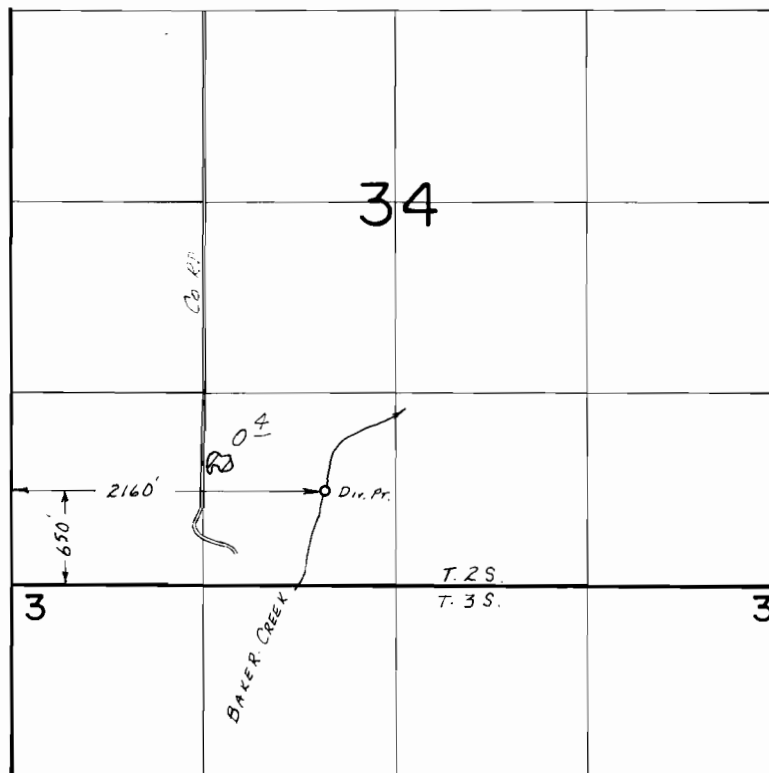

SCALE: 1" = 1320'

FINAL PROOF SURVEY UNDER

Application No. 52270 Permit No. 39334
IN NAME OF

KENT J. DUTSON

Surveyed July 18, 1984, by B.W. BISHOP