


T. 38S., R. 8W., W.M.

Sec. 22

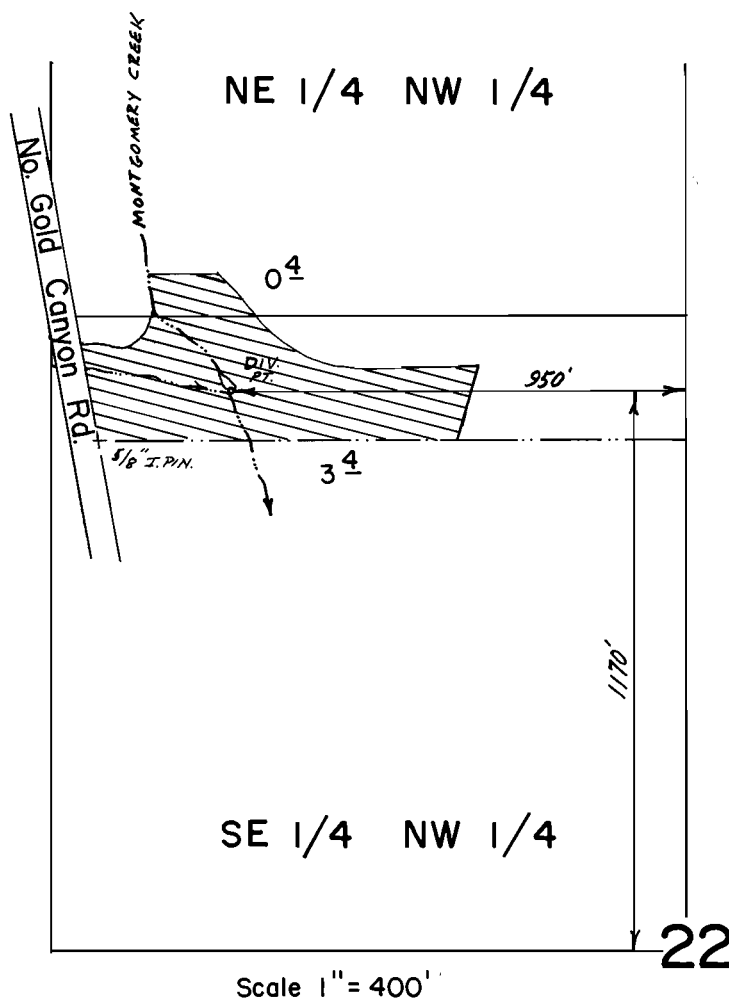

FINAL PROOF SURVEY

UNDER

Application No. 52468 Permit No. 39452
IN NAME OF

THOMAS J. BECK

Surveyed Nov. 8, 1984, by J. R. WOODROOF