


T.5S. R.28&3W. W.M.

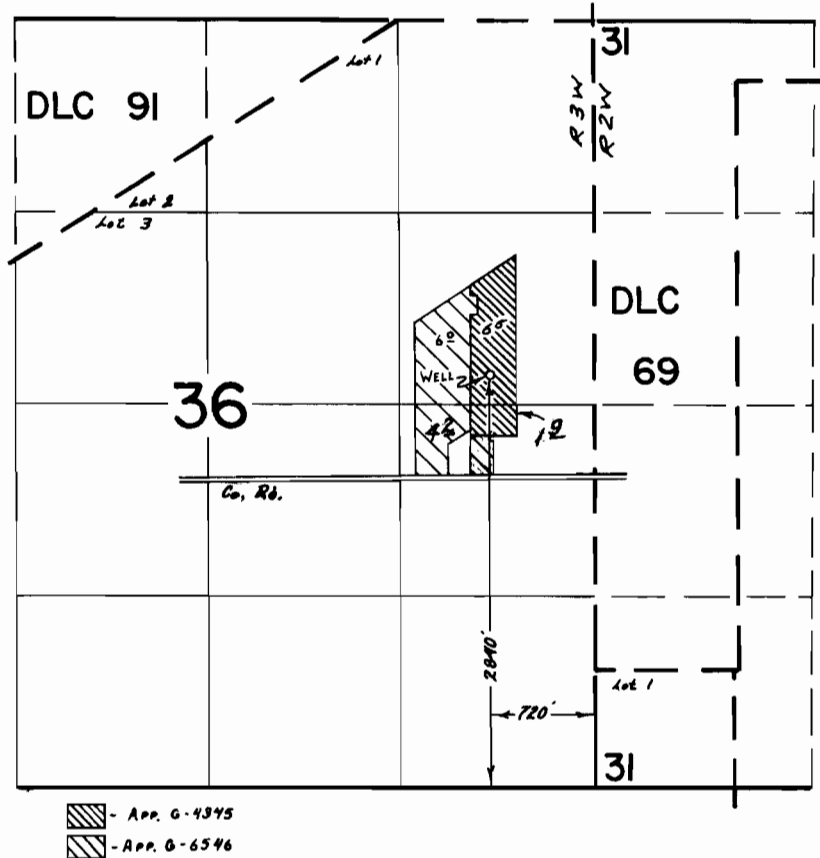

FINAL PROOF SURVEY
UNDER

Application No. G-4345 Permit No. G-4102
IN NAME OF

KENNETH LANDERS

Surveyed Oct. 29 1973, by R. B. MUCKEN
July 8 1980, by C. L. Hughes