
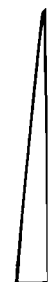


T. 3 S., R. 10 W., W. M.

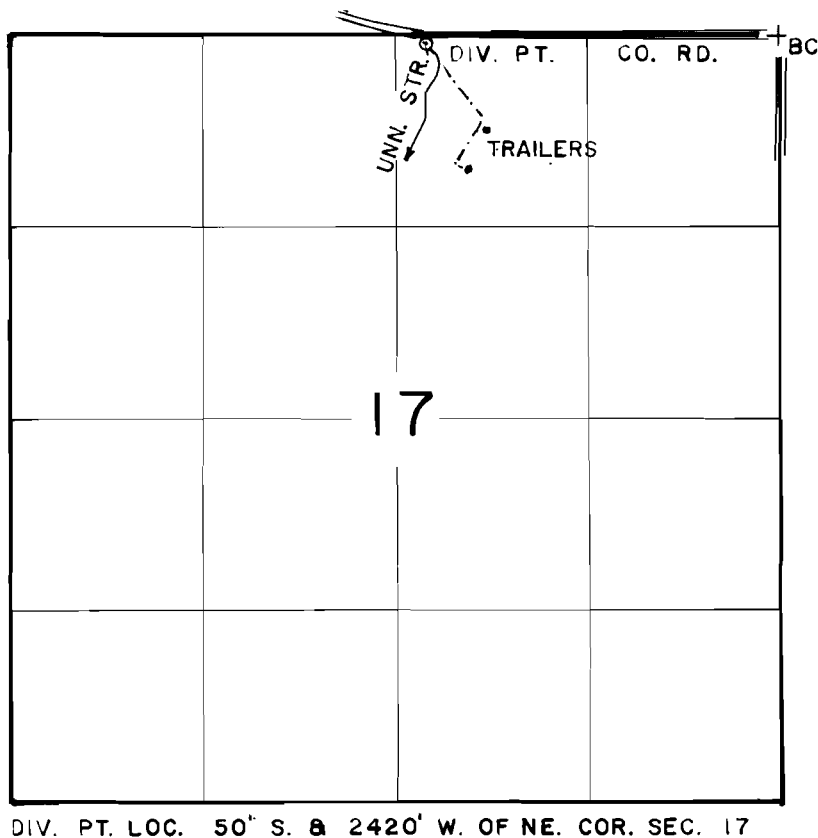

N

SCALE
1" = 1320'

FINAL PROOF SURVEY UNDER

Application No. 55733 Permit No. 41743
IN NAME OF

VICTOR NAPIER

Surveyed JUL 31 1984, by P. PAGTER