


T.17S.,R.5W.,W.M.

SECTION 20

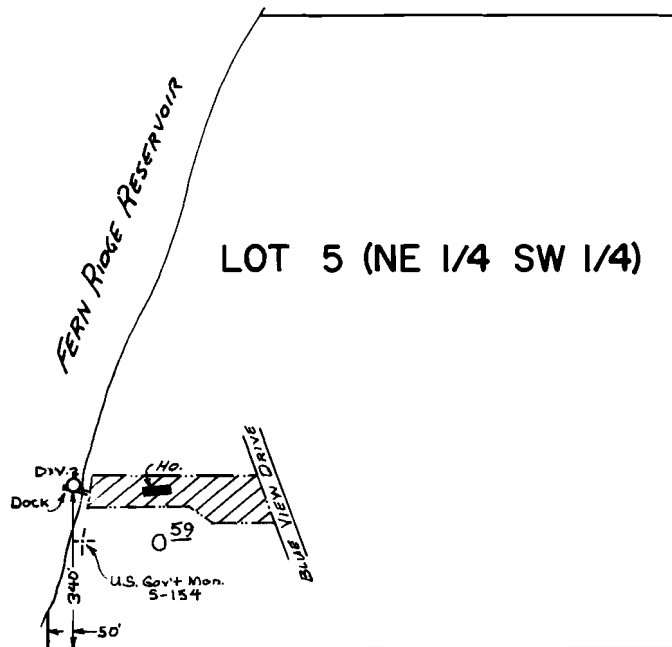

SCALE: 1" = 400'

FINAL PROOF SURVEY
UNDER

Application No. 54535.. Permit No. 41988.....
IN NAME OF

...JAMES... DAVID... MARSHALL.....

Surveyed June 14, 1982., by L. M. TOLL.....

L.D. LMT