


T.38S., R.7W., W.M.

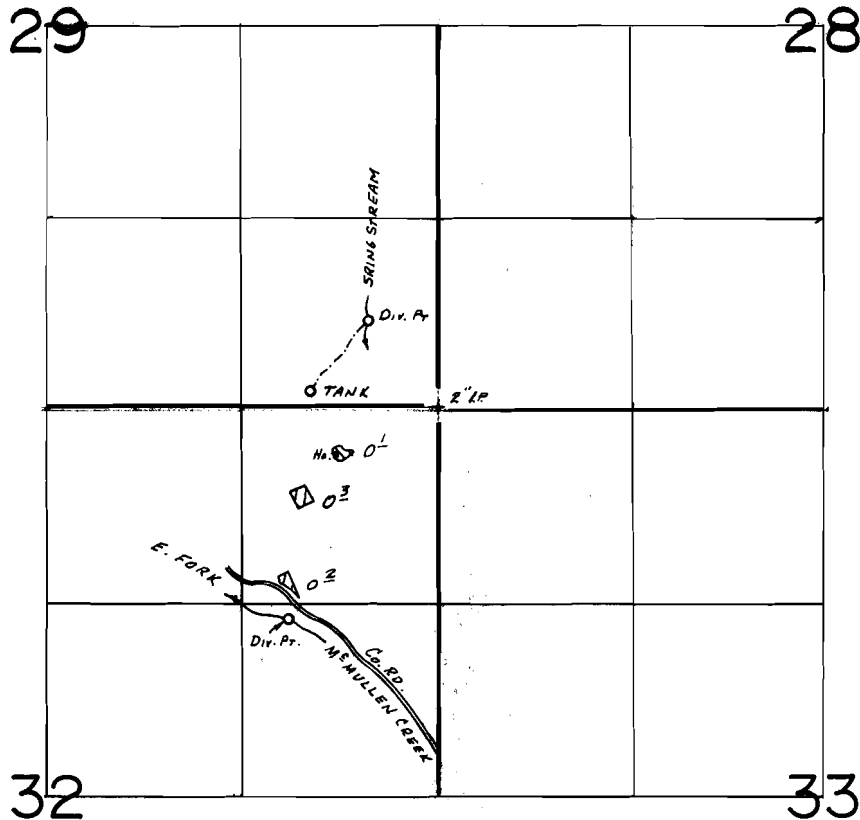

DIV. PTS. LOC.: M^S MULLEN CREEK- 1460'S. & 1040'W., SPRING STREAM- 540'N. & 490'W., BOTH FROM NE COR. SEC. 32.

SCALE: 1" = 1320'

FINAL PROOF SURVEY UNDER

Application No. 56257 42544
59378.. Permit No. 44633
IN NAME OF

EUGENE V. VOGEL

Surveyed Nov. 6..... 1984, by J.R. WOODRUFF.