


# T. 1 N. R. 13 E. W.M.

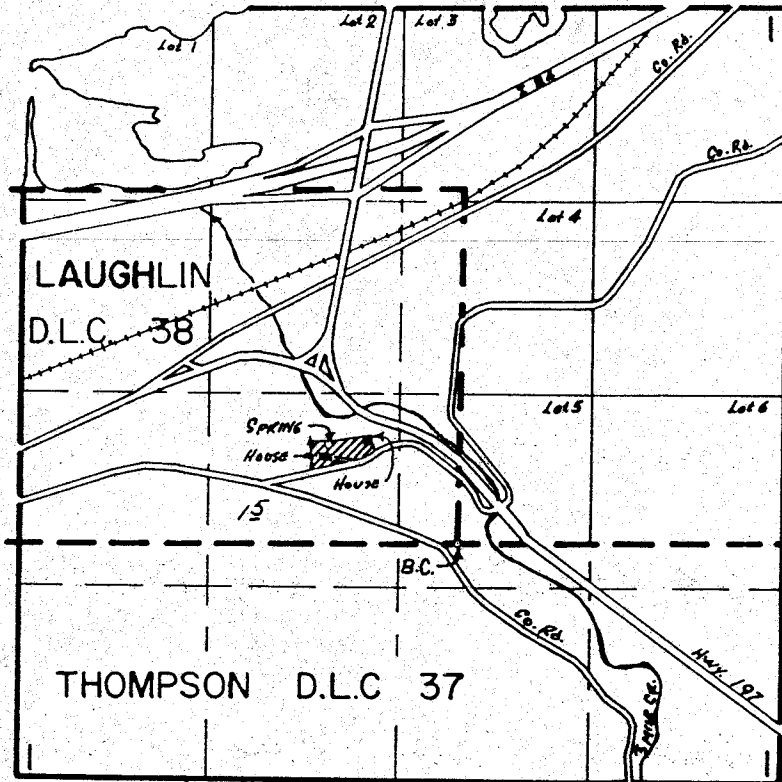

SPK. Loc. 650' N & 890' W From The SE Cor. Laughlin D.L.C. 38

## FINAL PROOF SURVEY UNDER

Application No. 56925 Permit No. 43001  
IN NAME OF

ROBERT DEAN TURNER

Surveyed Jan. 26, 1982, by T. PAUL