


T. 2S., R. 1W., W.M.

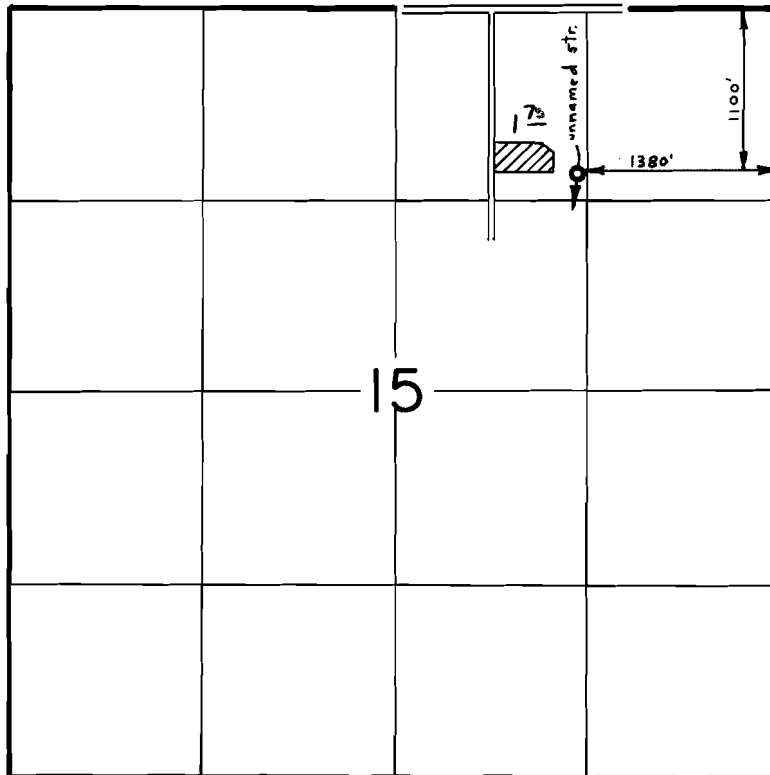

SCALE: 1" = 1320'

FINAL PROOF SURVEY
UNDER

Application No. 57803 Permit No. 43822
IN NAME OF

ELMER WOJAHN

Surveyed NOV. 16 1983, by L. TOLL