


T. 26 S., R. 3 W., W. M.

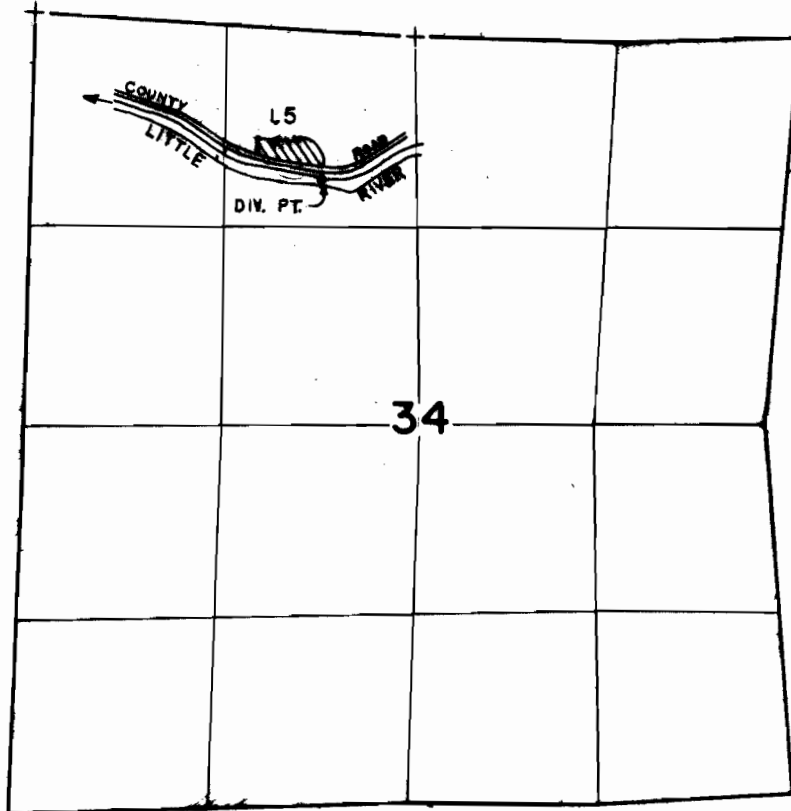

DIV. PT. LOCATED 1,020' S. & 590' W. FROM N. 1/4 COR. SEC. 34

SCALE: 4" = 1 mile

FINAL PROOF SURVEY
UNDER

Application No. 58353... Permit No. 44072....
IN NAME OF

JOHN D. & LORRAINE L. GILLISS

Surveyed JUL. 24, 1984., by L. CASHION...