



T. 33 S., R. 2 E., W.M.

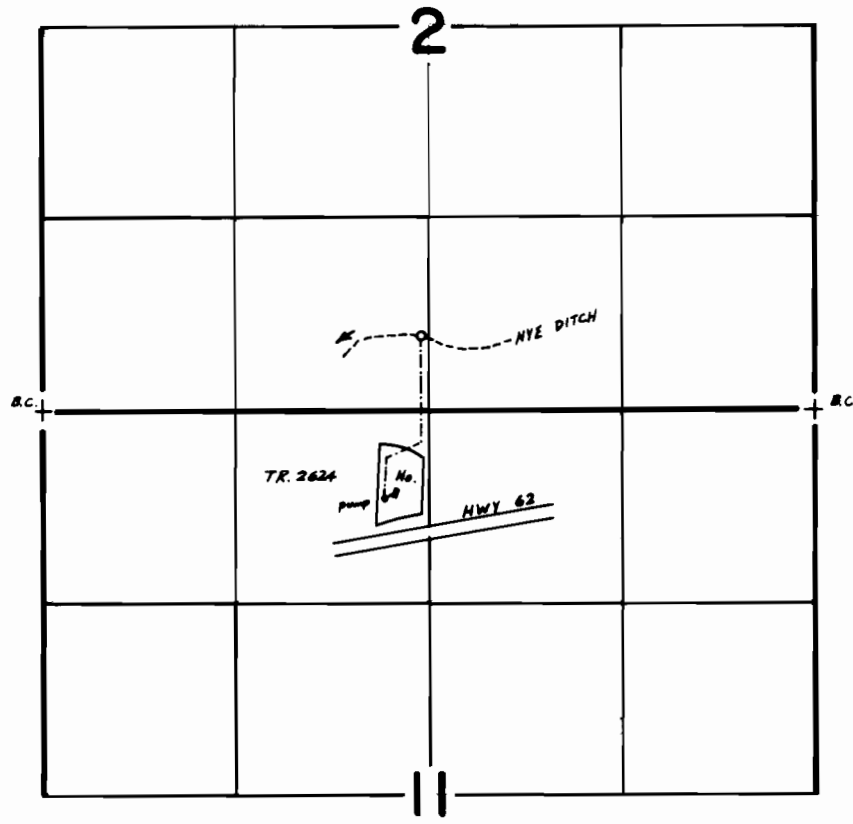

SCALE 1"=1320'

T. 32 S., R. 3 E.

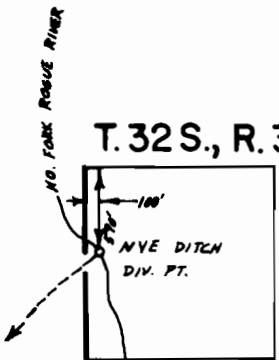

NW 1/4 SW 1/4  
SEC. 29

**FINAL PROOF SURVEY**  
UNDER

Application No. ~~58566~~ Permit No. 44170.....  
IN NAME OF

BRIAN...H....&...or...RENELDA...C....BOOTHBY

Surveyed May.24.. 1983, by B.S.JAMES.....